


BRANCH OFFICE
809 - 43RD STREET
KENOSHA, WISCONSIN 53140
PHONE: 414-658-4488

Buyer: John James Dulen, 3217 Chicago Club Road, Delevan, Wisconsin.

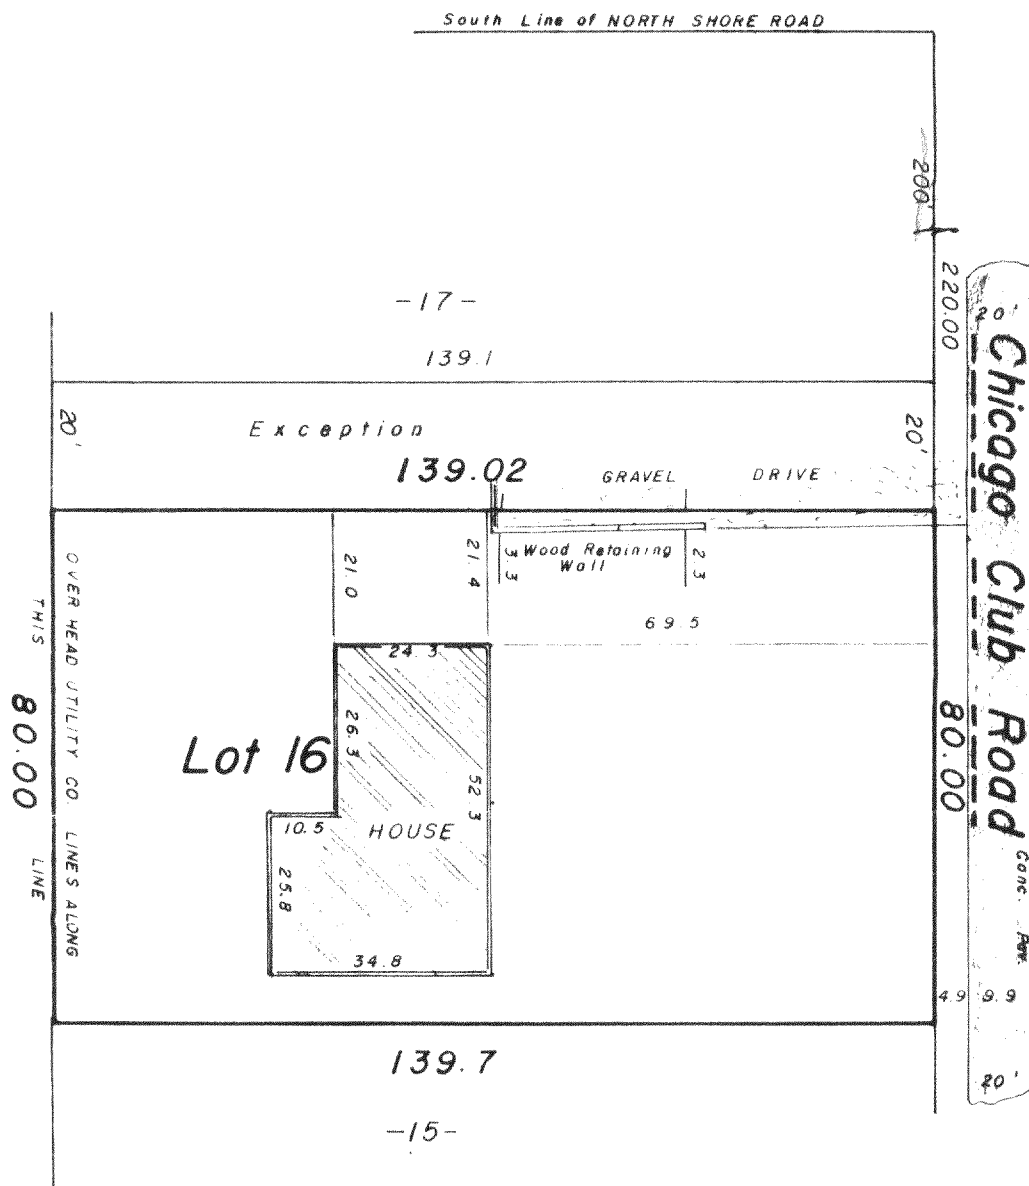


NOTE: This Mortgage Inspection was prepared for identificagion purposes for a real estate sale transaction. No corners were set by the request of Universal Mortgage Corp. Do not use this map for establishing fence lines or construction.

"I hereby certify that I have surveyed the above described property and that the above map is a true representation thereof and shows the size and location of the property, its exterior boundaries, the location of all visible structures and dimensions of all principal buildings thereon, boundary fences, apparent easements, roadways and visible encroachments, if any.

"This survey is made for the use of the present owners of the property, and also those who purchase, mortgage, or guarantee the title thereto within one year from date hereof."

YES MONUMENTATION HAS BEEN WAIVED IN ACCORDANCE
WITH A-E 5.01(b) OF THE WISCONSIN ADMINISTRATIVE
CODE

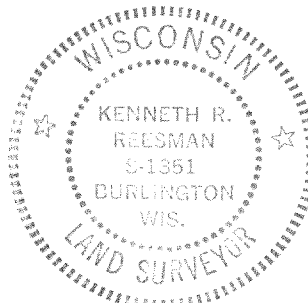

LEGEND

- ✕ PK NAIL FOUND
- PK NAIL SET
- FOUND IRON PIPE -
- ⚡ FOUND IRON PIPE -
- SET IRON PIPE -
- FOUND BRASS CAPPED MONUMENT
- FOUND CONCRETE MONUMENT
- X—X— FENCE
- () RECORDED AS
- EXISTING GROUND ELEVATION

SCALE - 1" = 30'

Kenneth Reesman
WISCONSIN REGISTERED LAND SURVEYOR

8/20/82

DATE _____

FIELD WORK BY

DRAWN BY

82130

JOB NUMBER

K & E FCH. 28

216-640-R