

FARRIS, HANSEN & COOPER, INC.

ENGINEERING, SURVEYING AND LAND PLANNING
718 W. WALWORTH ST. - P.O. BOX 487 - ELKHORN, WI 53121
OFFICE: 414/723-2088

MORTGAGE INSPECTION SURVEY

LOT 22 AND THE EAST 1/2 OF LOT 23, BLOCK 2,
INLET OAKS SUBDIVISION NO. 4, TOWN 2 NORTH,
RANGE 16 EAST, WALWORTH COUNTY, WISCONSIN.

NOTE: This is not a "Property Survey" as de-
fined in Chapter A-E 5.01 of the Wisconsin
Administrative Code.

BUYER: Mark Lutz

SELLER: Terry Loebs

ORDERED BY: Johnston Mortgage Company
Attn.: Richard Socher

LEGEND

- 1" dia. iron pipe found
- x—Woven wire fence


I HEREBY CERTIFY that this map is a true and
accurate representation of the lot lines as
found to be monumented, and of the buildings
located thereon to the best of my knowledge
and belief.

Daniel D. Cooper


Daniel D. Cooper RLS No. 1464

25 Oct. 1978

Date

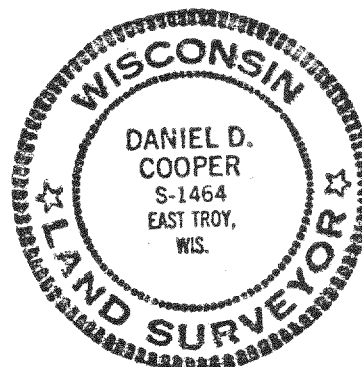

SCALE 1"=30'

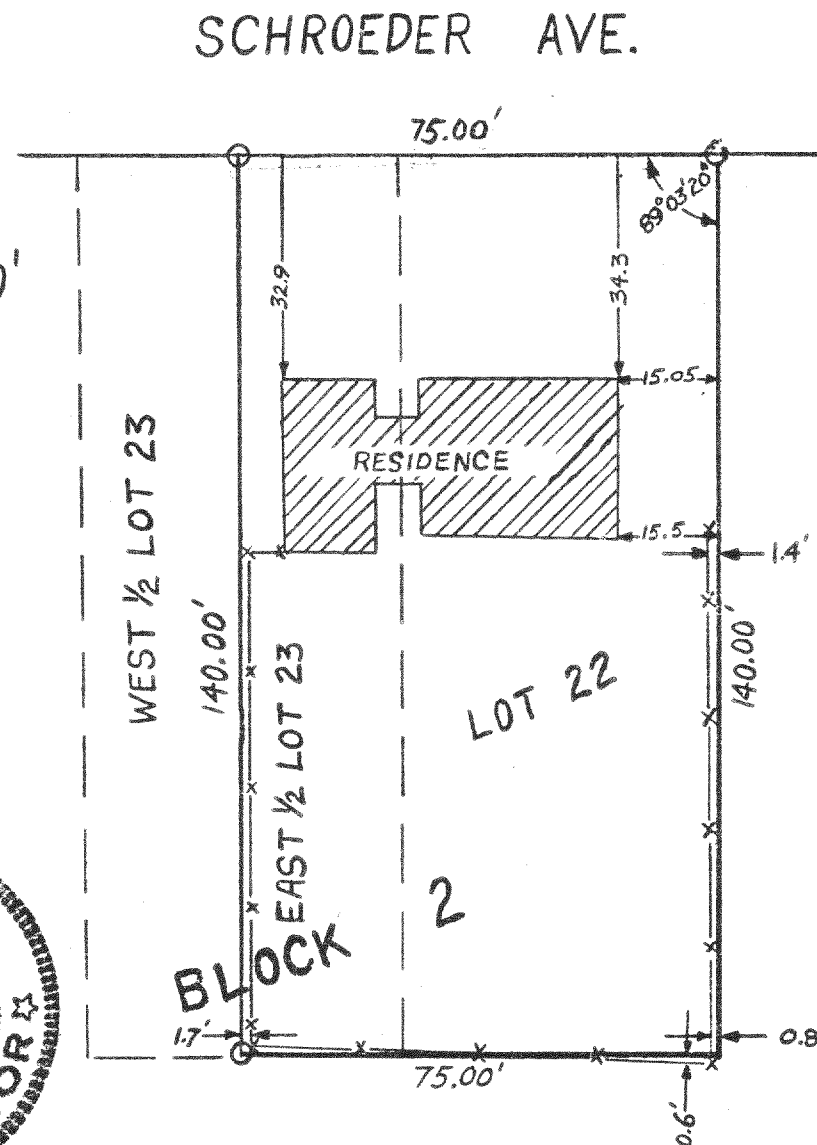

DRAWING NUMBER 1424

FIN4-12B

216-658