

A hand-drawn site plan of a property. The property is bounded by a chain-link fence, indicated by a zigzag line and the text "Chain Link Fence". The overall dimensions of the property are 50.0' wide and 140.0' deep. The plan shows two buildings: a "RESIDENCE" and a "GARAGE". The residence is a rectangle measuring 30.9' by 13.9', with a setback of 7.8' from the bottom boundary. The garage is a rectangle measuring 13.7' by 13.9', with a setback of 3.0' from the right boundary. The plan also shows various setbacks and dimensions: 0.6' and 0.7' from the top-left corner, 0.5' from the top-right corner, and 20' from the bottom boundary to "First Street". A north arrow is located in the bottom right corner, pointing towards the upper right.

LEGAL DESCRIPTION: Lot 13, Block 2, Inlet Oaks Sub-
division Number 3, Town of Delavan, Walworth County,
Wisconsin




O = Iron Pipe Found

WORK ORDERED BY: Sandra J. Butler for Waukesha Sav-
ings & Loan -- East Troy Office

Dated this 11th day of September, 1978

Robert A. Farris
Robert A. Farris RLS

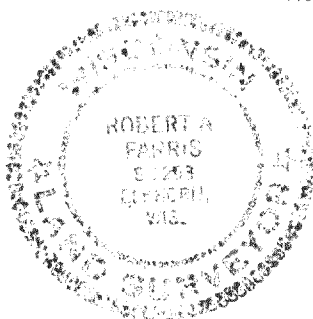

FARRIS, HANSEN & COOPER, INC.

715 W. WALWORTH AVE. P.O. BOX 487 216-659
EARTHORN, WISCONSIN 53121
TELEPHONE 414-723-2098

DRAWING NO. 1401