
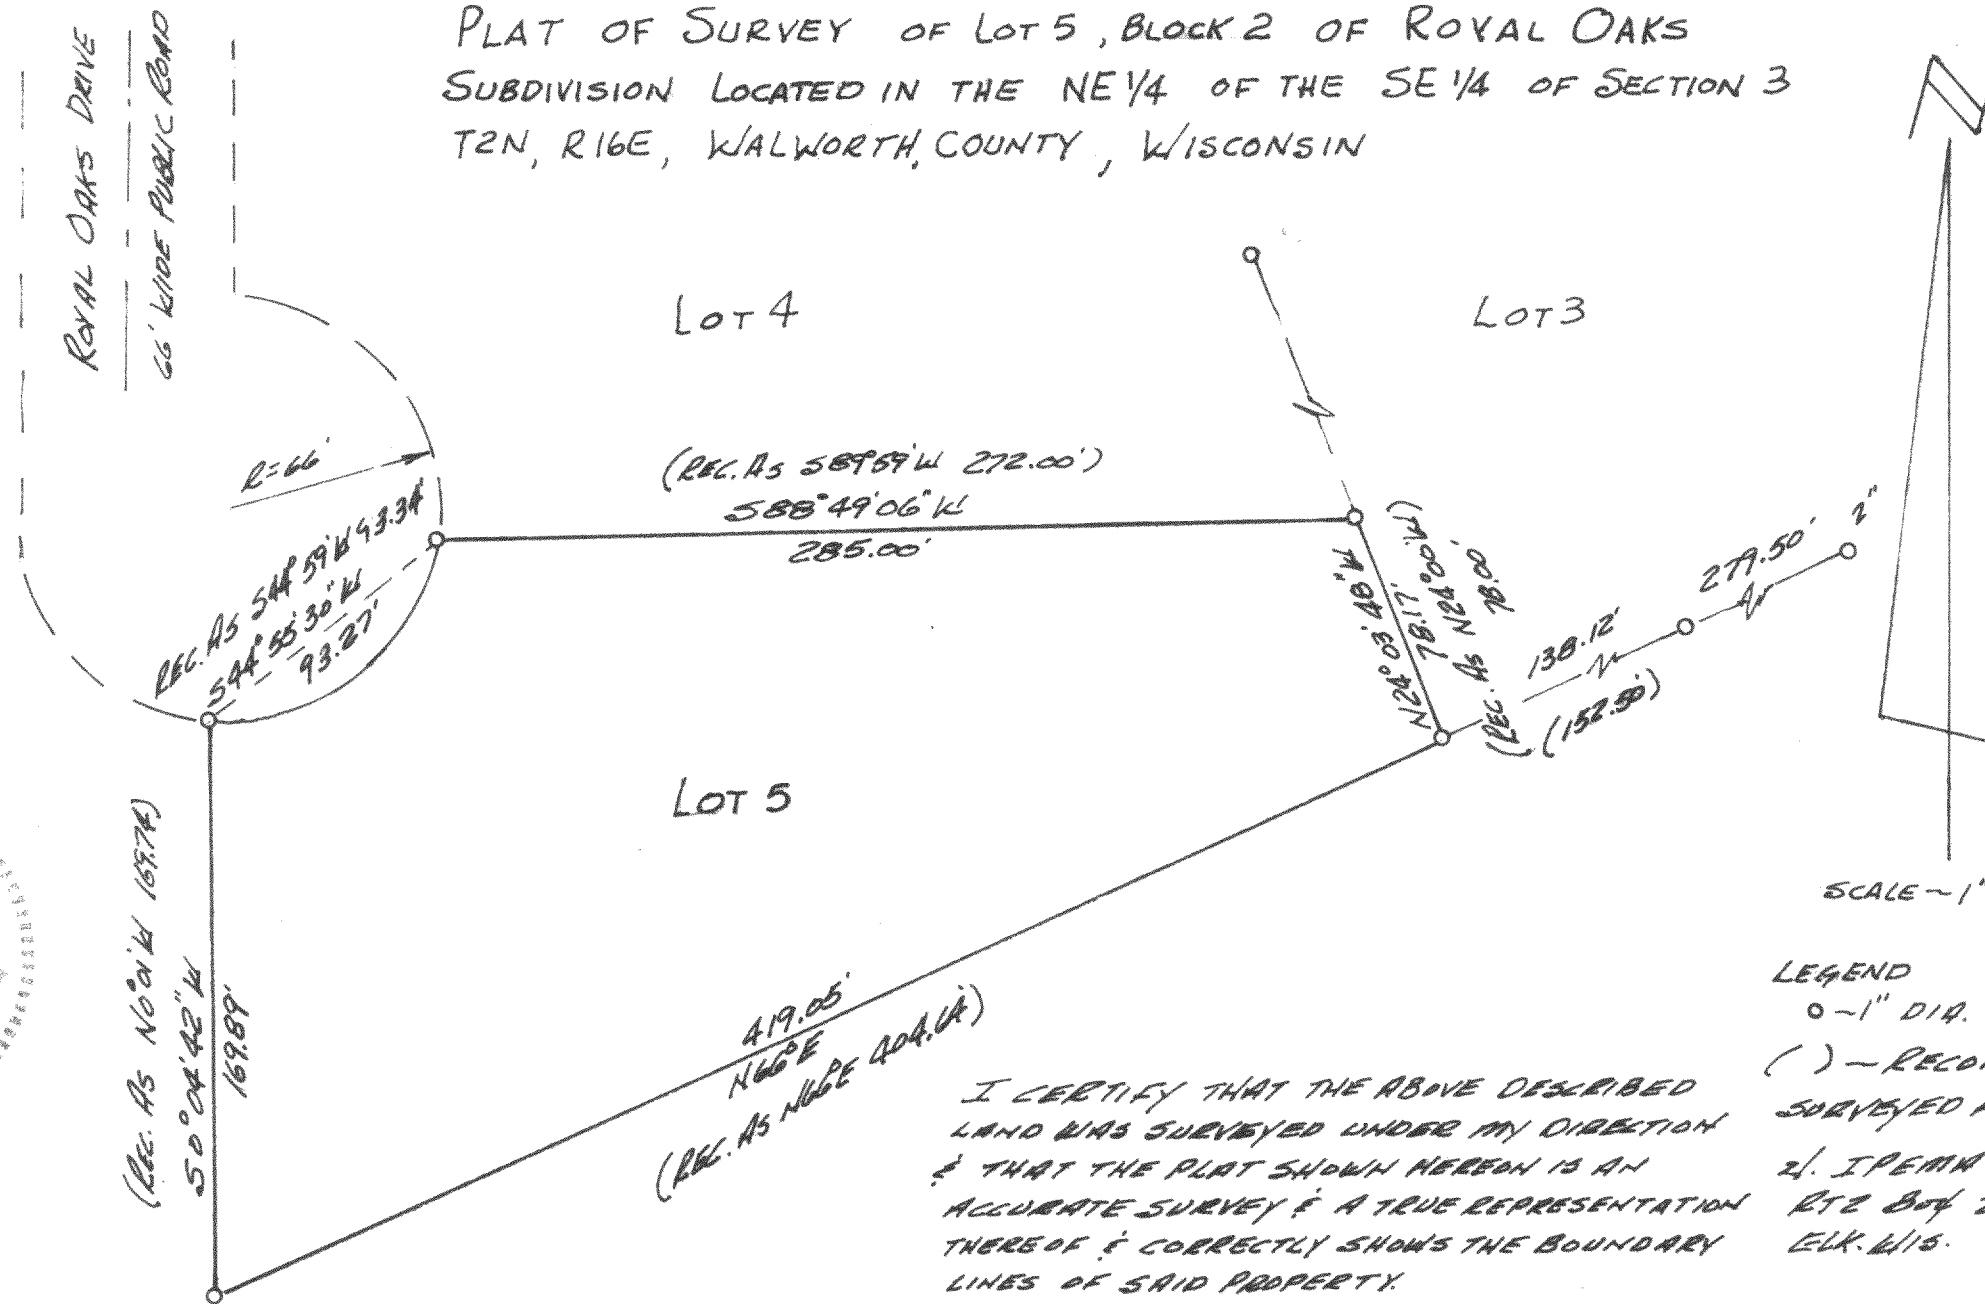


PLAT OF SURVEY OF LOT 5, BLOCK 2 OF ROYAL OAKS
SUBDIVISION LOCATED IN THE NE 1/4 OF THE SE 1/4 OF SECTION 3
T2N, R16E, WALWORTH COUNTY, WISCONSIN

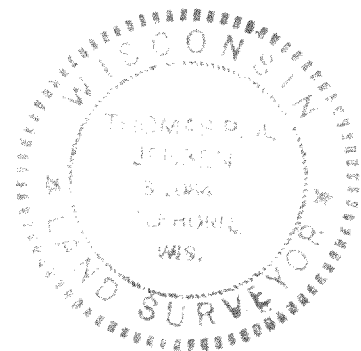

LEGEND
0-1" DIA. FOUND IRON PIPE
() - RECORDED AS SURVEYED FOR:

2. I PERM
RTZ BOX 264A
ELK. WIS.

I CERTIFY THAT THE ABOVE DESCRIBED
LAND WAS SURVEYED UNDER MY DIRECTION
& THAT THE PLAT SHOWN HEREON IS AN
ACCURATE SURVEY & A TRUE REPRESENTATION
THEREOF & CORRECTLY SHOWS THE BOUNDARY
LINES OF SAID PROPERTY.

MAY 24, 1979

THOMAS P.A. JENSEN
THOMAS P.A. JENSEN 5-1084
JENSEN SURVEYING & MAPPING
ELKHORN, WISCONSIN

NOTE: WE FOUND ALL OF THE
ORIGINAL IRON PIPE LOT
CORNER MARKERS AND THE
LOTS DO NOT MATCH THE
RECORDED SUBD. PLAT.

FR0L-9

216-709

719.087