


DUNHAM SURVEYING, S.C.
SURVEYING & SUBDIVIDING
DELAVER, WISCONSIN 53115

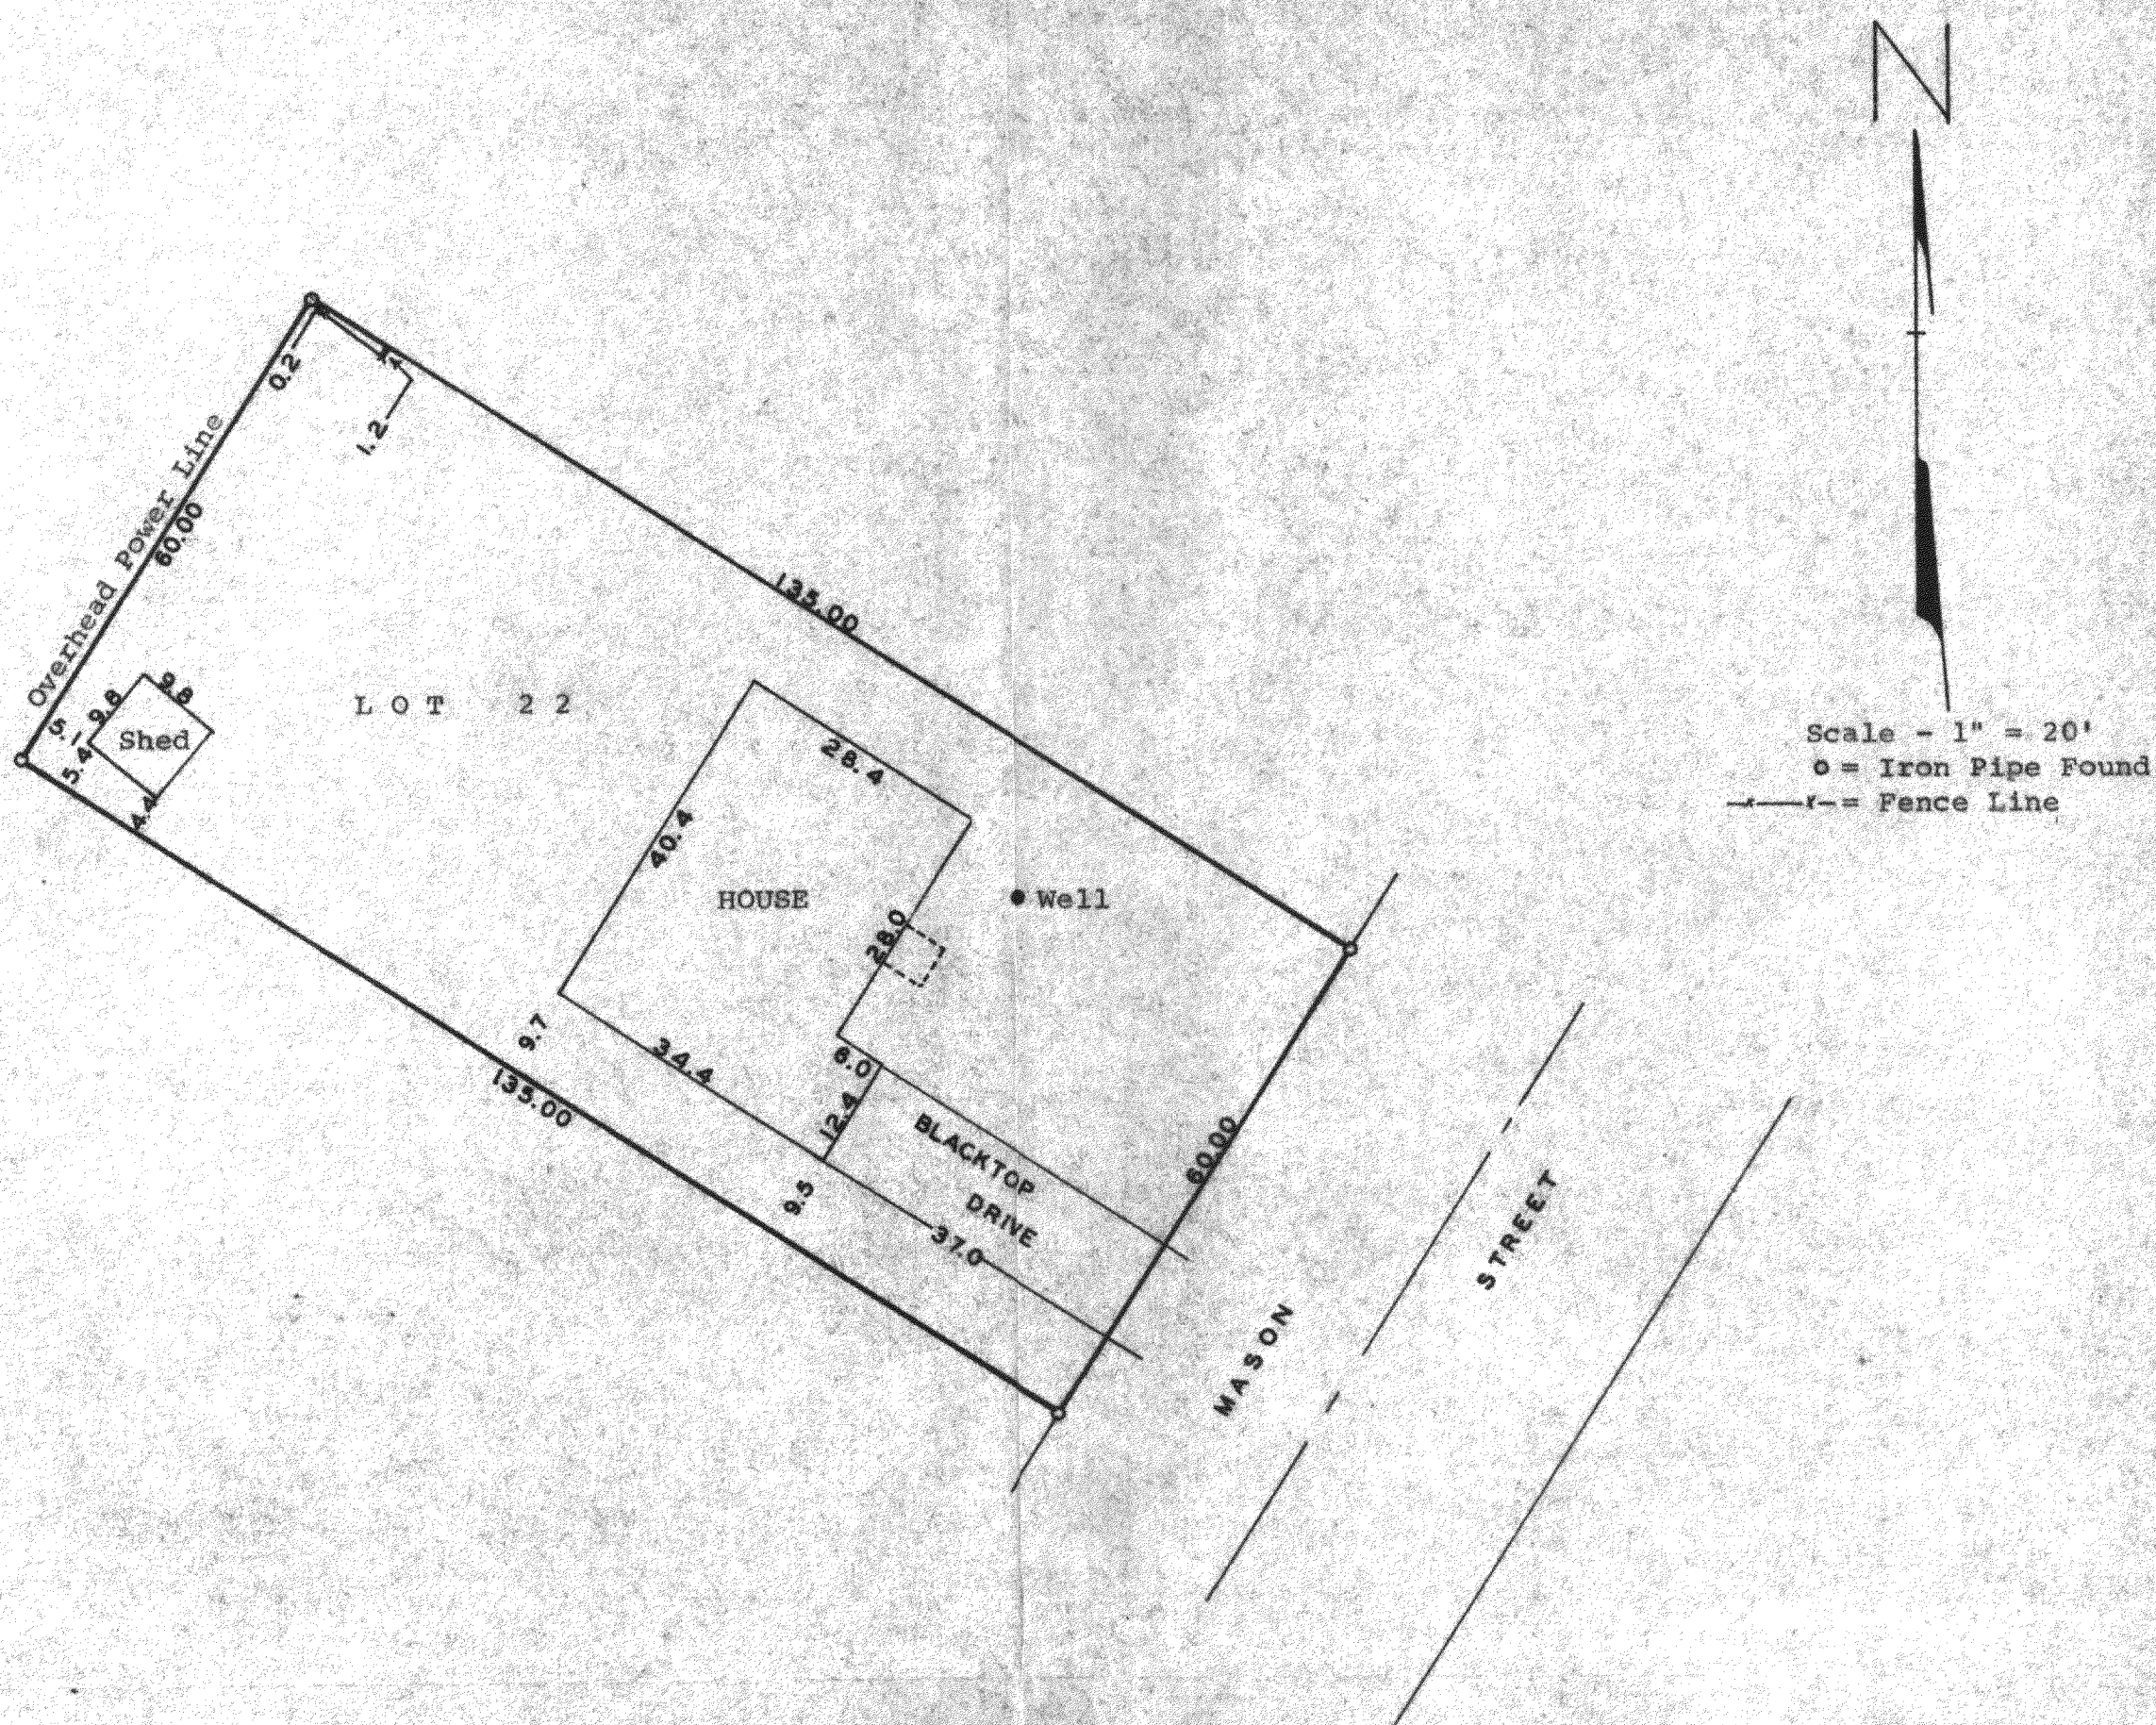

STATE OF WISCONSIN) SS
COUNTY OF WALWORTH)

I, James M. Dunham, Surveyor, certify that I have surveyed the property described as follows,

Lot 22 in Block 1 in the Plat of Delmar, being a subdivision of part of Government Lot 3, part of the Southwest $\frac{1}{4}$ of the Southwest $\frac{1}{4}$, all of the Southeast $\frac{1}{4}$ of the Southwest $\frac{1}{4}$ and part of the NE $\frac{1}{4}$ of the Southwest $\frac{1}{4}$ of Section 27, T2N, R16E, of the 4th P.M., Walworth County, Wisconsin.

and that the above map is a true representation thereof and shows the size and location of the property, its exterior boundaries, the location of all visible structures and dimensions of all principal buildings thereon, boundary fences, apparent easements, roadways and visible encroachments, if any.

This survey is made for the use of the present owners of the property, and also those who purchase, mortgage, or guarantee the title thereto within one (1) year from date hereof.

February 27, 1980

James M. Dunham
James M. Dunham, Surveyor

