


PLAT OF SURVEY

A PARCEL OF LAND LOCATED IN THE NE 1/4 OF
SECTION 9, TOWNSHIP 2 NORTH, RANGE 16 EAST IN
DEHAVAN TOWNSHIP, WALWORTH COUNTY, WISCONSIN

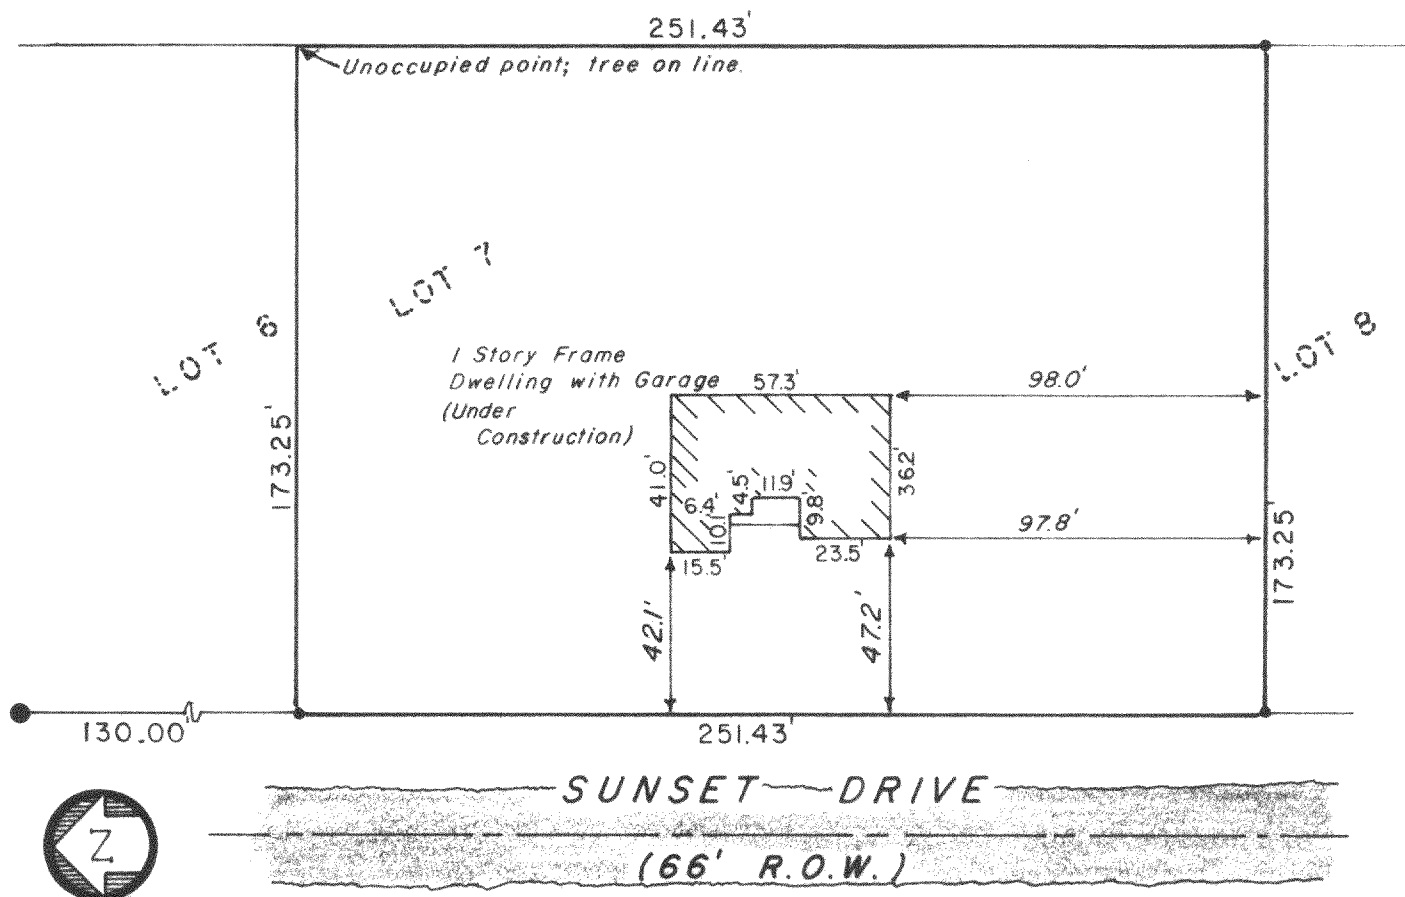

KEY


- Iron Rod Found, 1-1/4" Dia.
- Iron Rod Found, 3/4" Dia.

DESCRIPTION: Lot 7 of Sunset Acres, a recorded subdivision located in the NE 1/4 of Section 9, Township 2 North, Range 16 East in Delavan Township, Walworth County, Wisconsin and recorded as Document No. 49160.

SURVEYOR'S CERTIFICATE: I hereby certify that I have surveyed the above described property and that the above map is a true representation thereof and shows the size and location of the property, its exterior boundaries, apparent easements, roadways and visible encroachments, if any. This survey is made for the use of the present owners of the property, and also those who purchase, mortgage, or guarantee the title thereto within one (1) year from date hereof.

February 11, 1980
Date

Dennis W. Valentine
Dennis W. Valentine, RLS 1419

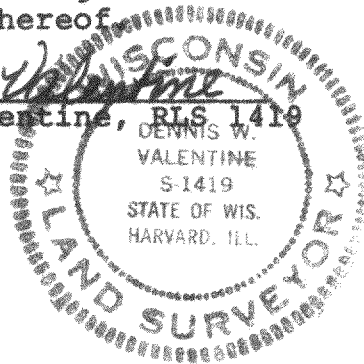

SURVEYOR'S OFFICE

Prepared By

VALENTINE AND ASSOCIATES, INC.
DEHAVAN, WISCONSIN

Prepared For

MARTIN VENEMA
DEHAVAN, WISCONSIN

Date

2/10/80

Sheet Number

1 of 1

Job Number

80002

Reference

File

FSVA 00007

216-720