


DUNHAM SURVEYING, S.C.
SURVEYING & SUBDIVIDING
DELAVAN, WISCONSIN 53115

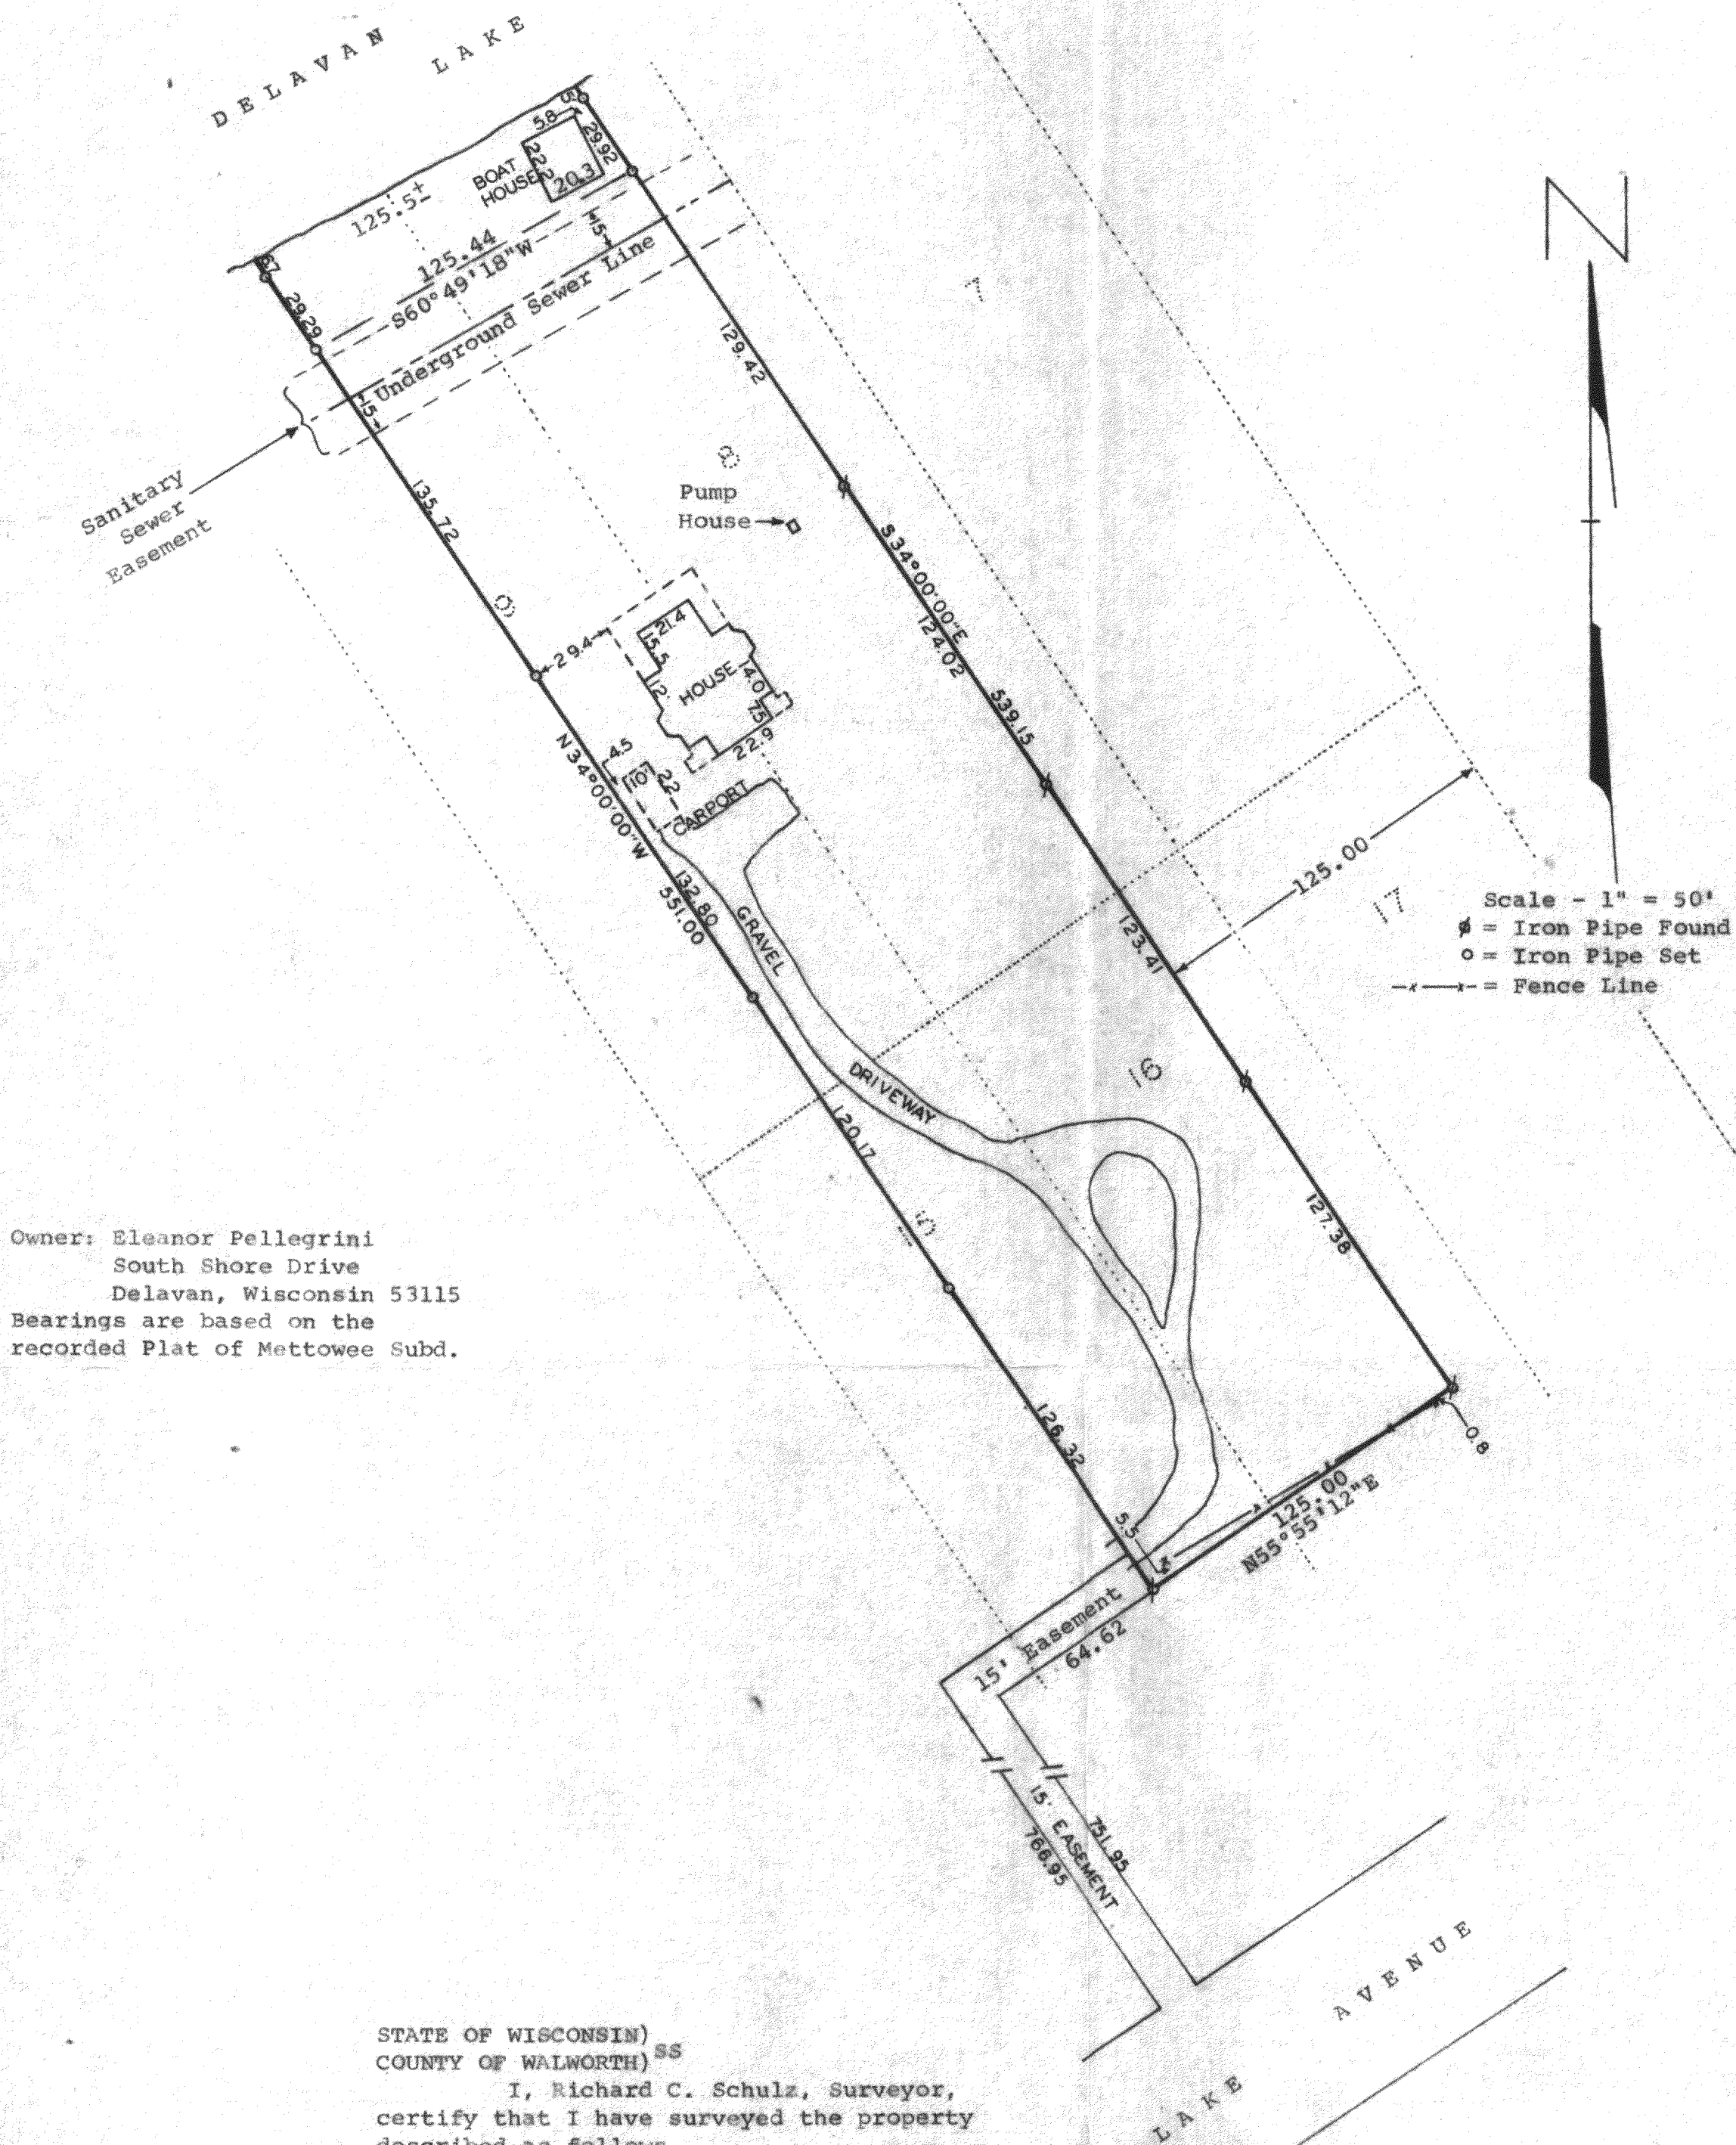

Owner: Eleanor Pellegrini
South Shore Drive
Delavan, Wisconsin 53115
Bearings are based on the
recorded Plat of Mettowee Subd.

STATE OF WISCONSIN)
COUNTY OF WALWORTH) SS

I, Richard C. Schulz, Surveyor,
certify that I have surveyed the property
described as follows,

Part of Lots 8, 9, 15 and 16 of Mettowee
Subdivision in Section 33, T 2 N, R 16 E,
Walworth County, Wisconsin, described as
follows: Commencing at a point 125 feet
Southwest of the east line of said Lot 17 and in a line drawn parallel to the south line
of said Lots 5, 15, 16 and 17 and 751.95 feet equidistant therefrom; thence Northwesterly
on a line drawn parallel to the east line of said Lot 17 to the shore of Delavan Lake at
the low water mark; thence Southwesterly along the shore of Delavan Lake at the low water
mark to a point which would be intersected by a line drawn parallel to the east line of
said Lot 17 and 250 feet equidistant therefrom; thence Southeasterly and parallel with the
east line of said Lot 17 to a point where the line thus formed would intersect a line
drawn parallel with the south line of said Lots 5, 15, 16 and 17 and 751.95 feet equidistant
therefrom; thence Northeasterly to the place of beginning.

and that the above map is a true representation thereof and shows the size and location of the property,
its exterior boundaries, the location of all visible structures and dimensions of all principal buildings
thereon, boundary fences, apparent easements, roadways and visible encroachments, if any.
This survey is made for the use of the present owners of the property, and also those who purchase,
mortgage, or guarantee the title thereto within one (1) year from date hereof.
March 23, 1982

Richard C. Schulz
Richard C. Schulz, Surveyor

