


DUNHAM SURVEYING, S.C.
SURVEYING & SUBDIVIDING
DELAVAN, WISCONSIN 53115

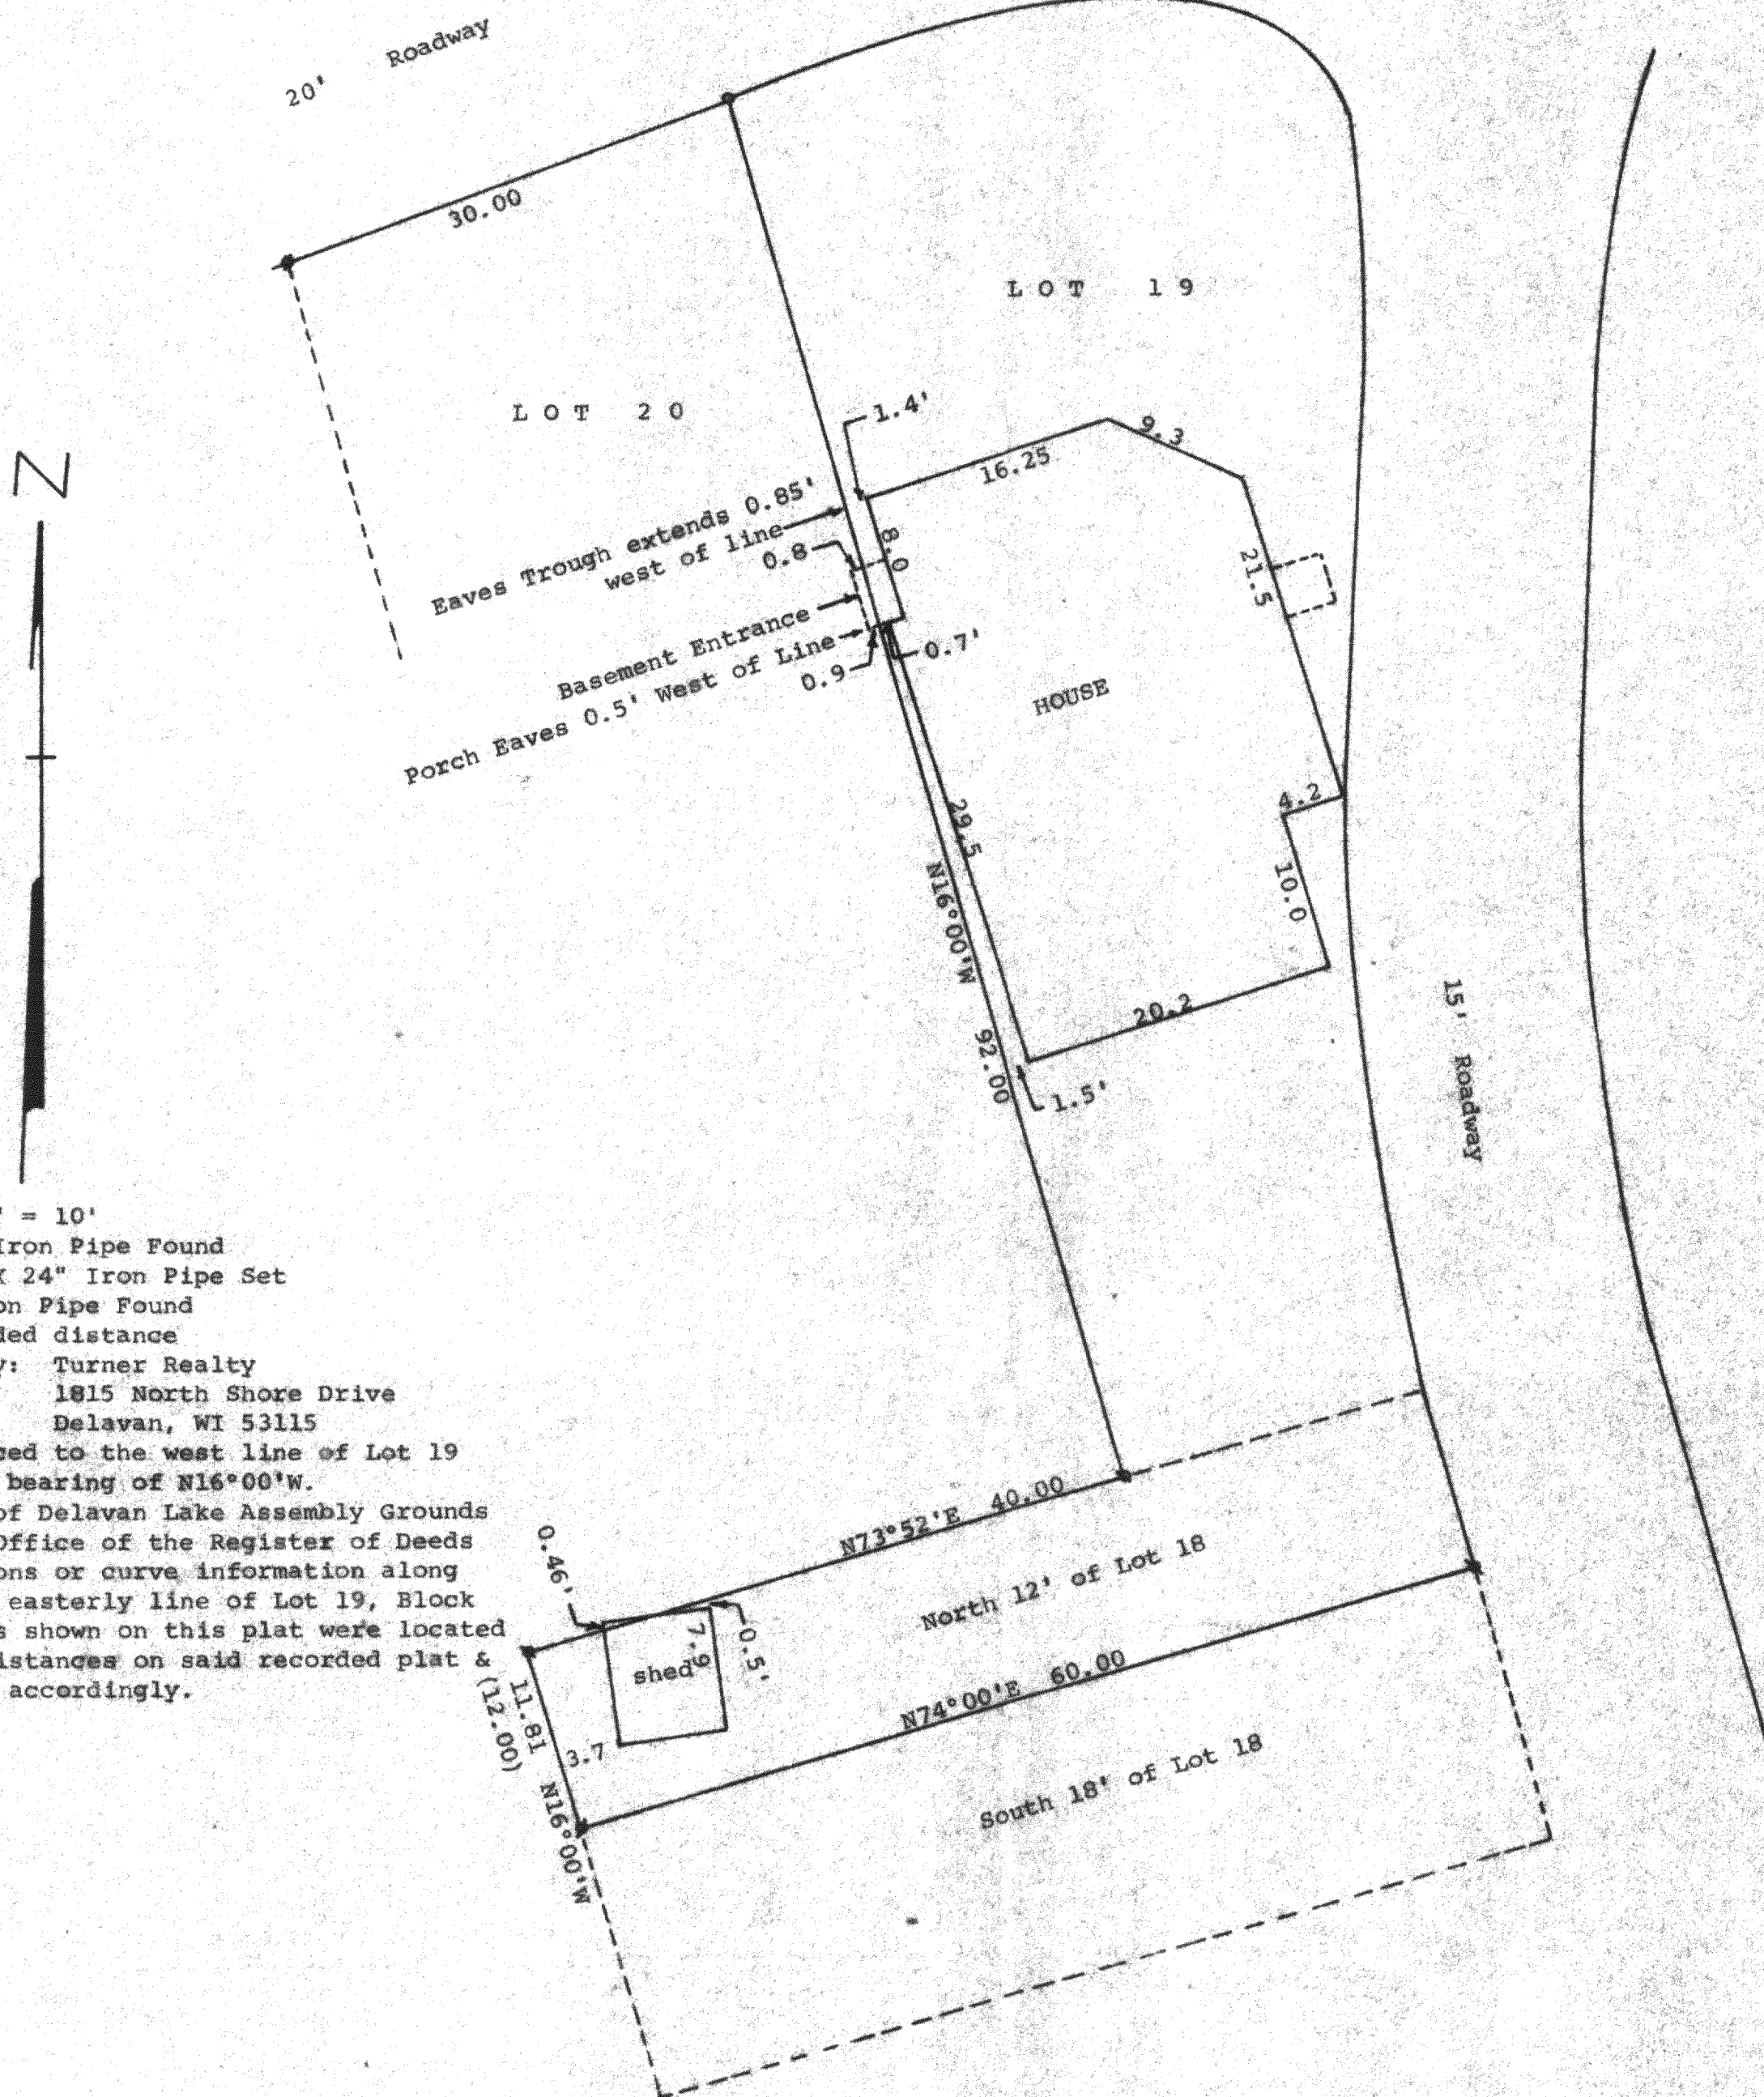

Scale - 1" = 10'
 * = 3/4" Iron Pipe Found
 o = 3/4" X 24" Iron Pipe Set
 v = 1" Iron Pipe Found
 (0.00) = recorded distance

Survey ordered by: Turner Realty
 1815 North Shore Drive
 Delavan, WI 53115

Bearings referenced to the west line of Lot 19
 with the assumed bearing of N16°00'W.

Note: The plat of Delavan Lake Assembly Grounds
 recorded in the Office of the Register of Deeds
 shows no dimensions or curve information along
 the northerly or easterly line of Lot 19, Block
 "O". These lines shown on this plat were located
 by scaling the distances on said recorded plat &
 drawing the plat accordingly.

STATE OF WISCONSIN) SS
 COUNTY OF WALWORTH)

I, George T. Dunham, Surveyor, certify that I have surveyed the
 property described as follows:
 Lot 19 and the Northerly 12.00 feet of Lot 18, Block "O", Delavan
 Lake Assembly Grounds, located in the Southeast Fractional 1/4 of
 Section 21, T 2 N, R 16 E, Walworth County, Wisconsin,
 and that the above map is a true representation thereof and shows the size
 and location of the property, its exterior boundaries, the location of all
 visible structures and dimensions of all principal buildings thereon,
 boundary fences, apparent easements, roadways and visible encroachments,
 if any, and that I have surveyed the property hereon described according
 to the official records, to the best of my knowledge and belief.
 August 30, 1983

George T. Dunham
 George T. Dunham, Surveyor

