
KOLB LAND CONSULTING, INC. SHEET 1 OF 2 SHEETS

LAND SURVEYING . SUBDIVIDING . LAND PLANNING

LAKE GENEVA, WISCONSIN 53147

WHITEWATER, WISCONSIN 534-90

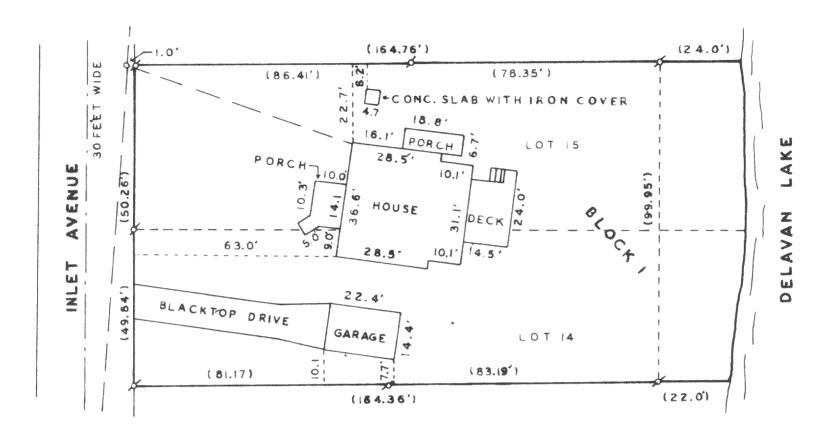

MORTGAGE INSPECTION OF

LOTS 14 AND 15, BLOCK 1, INLET DAKS, A SUBDIVISION LOCATED IN TOWN 2 NORTH, RANGE 16 EAST, WALWORTH COUNTY, WISCONSIN.

ORDERED BY: ANCHOR SAVINGS & LOAN ASSOCIATION 500 E. WALWORTH AVE. DELAVAN, WISCONSIN 53115

BUYER: RICHARD SCHNIENDER

COMPLIANCE WITH A-E 3, 5(F),6(A),(B),(C),(D) AND 7 HAS BEEN WAIVED BY THE CLIENT, IN AGREEMENT WITH THE SURVEYOR, AS PERMITTED IN A-E5.01(B).



SCALE - 1" = 30"

LEGEND

(7) - RECORDED AS AND AS SHOWN

O - UNTILITY POLE

Narole W Holl

WISCONSIN REGISTERED LAND SURVEYOR, S- 187

216-782-K