
DUNHAM SURVEYING, S.C. SURVEYING & SUBDIVIDING DELAVAN, WISCONSIN 53115

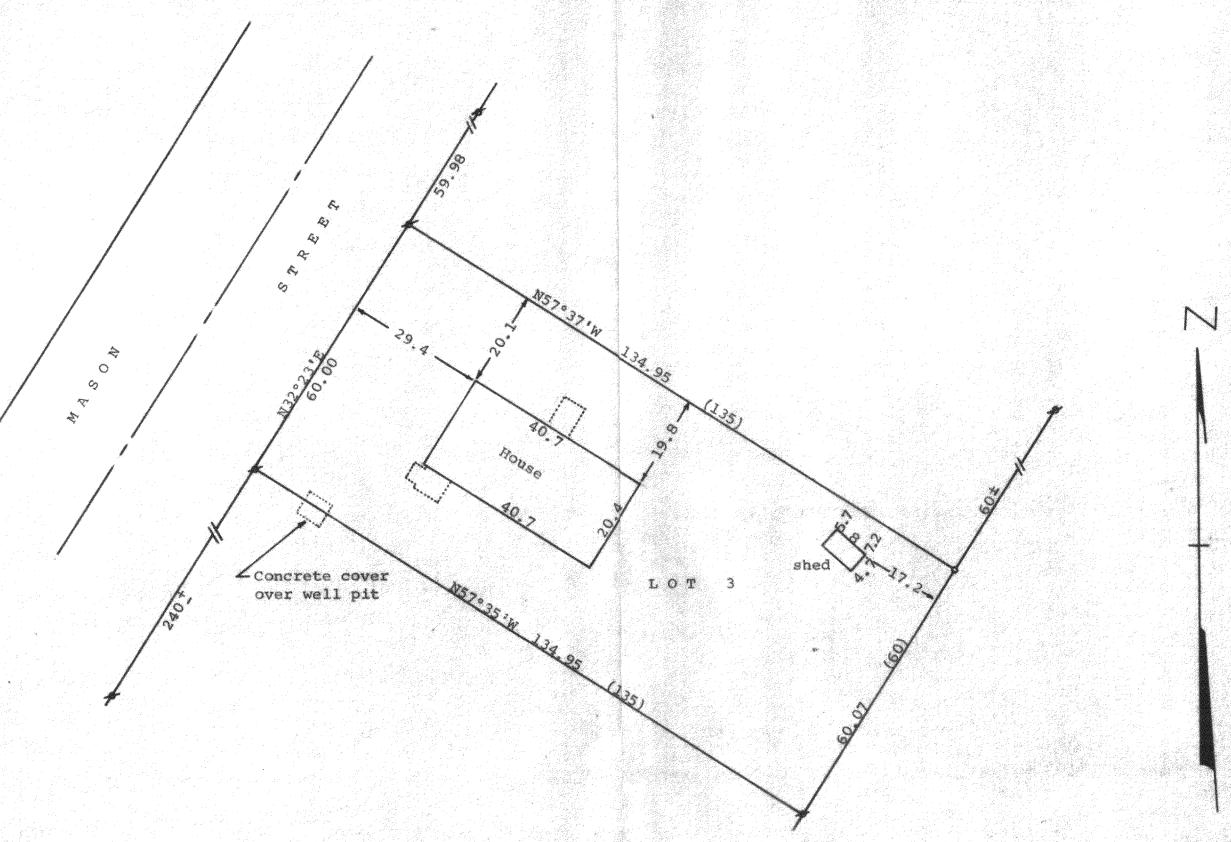

= 1" Iron Pipe Found o = 1" Iron Pipe Found 1' below ground. Pulled and set 1" X 24" at surface (0.00) = recorded distance Bearings used are those of record Owner: Roy Anderson Mason Street RFD Delavan, WI 53115

STATE OF WISCONSIN) SS COUNTY OF WALWORTH)

I, George T. Dunham, Surveyor, certify that I have surveyed the

property described as follows:

Lot 3 in Block 2 of Delmar, a subdivision located in Section 27, T 2 N, R 16 E, Walworth County, Wisconsin, and that the map shown above is a true representation thereof and shows the size and location of the property, its exterior boundaries, the location of

all visible structures and dimensions of all principal buildings thereon, boundary fences, apparent easements, roadways and visible encroachments, if any, and that I have surveyed the property hereon described according to the official records, to the best of my knowledge and belief. December 8, 1983

George T. Dunham, Surveyor

