


CHANNEL DRIVE

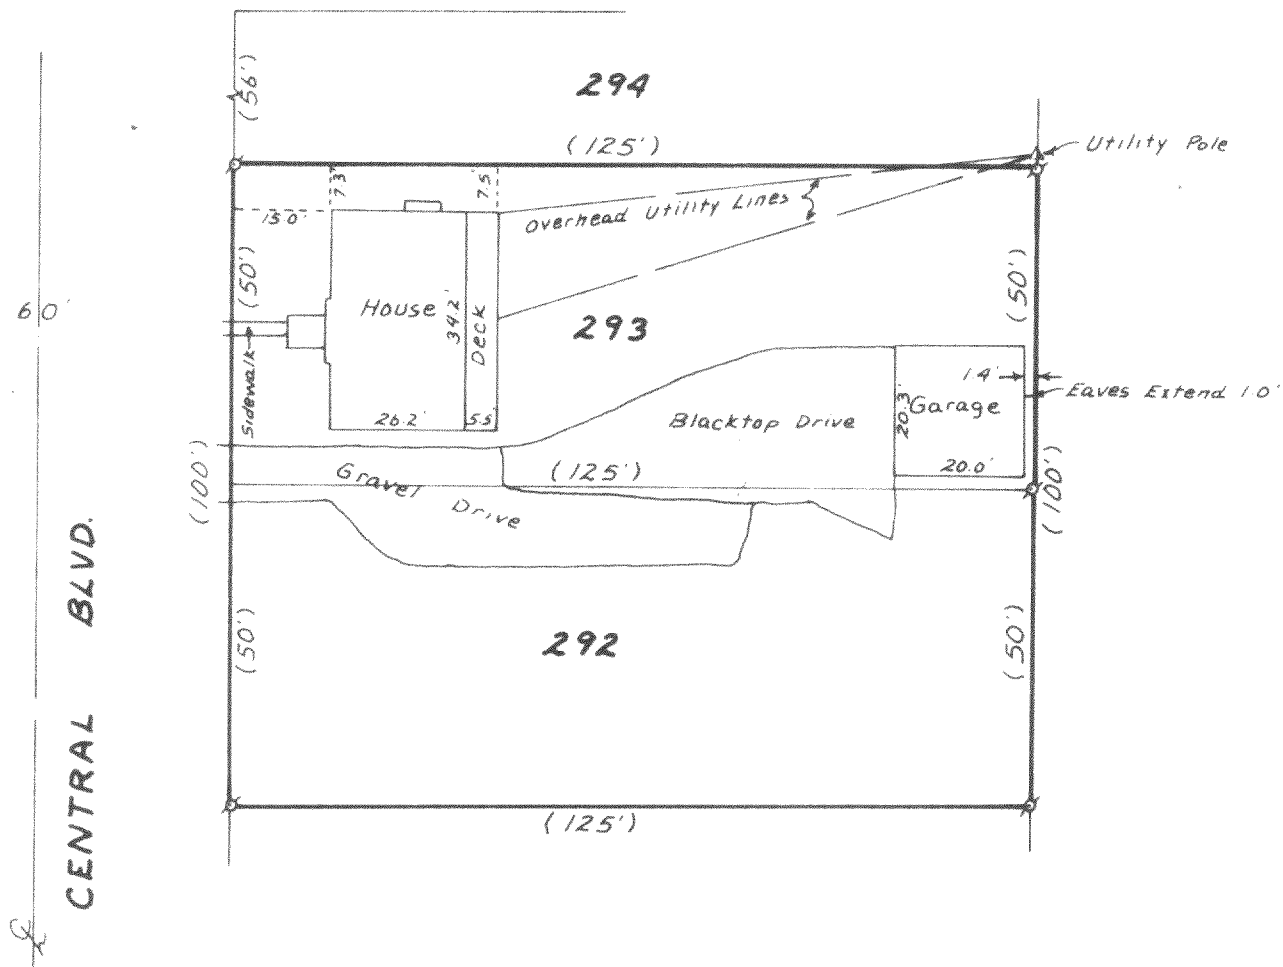


LOTS 292 AND 293, LAKE DELAVAN HIGHLANDS,  
TOWN 2 NORTH, RANGE 16 EAST, WALWORTH  
COUNTY, WISCONSIN.

ORDERED BY: ANCHOR SAVINGS & LOAN ASSOCIATION  
500 EAST WALWORTH AVE.  
DELAVAN, WI 53115

OWNER: DELLA ROSS LINDLOFF  
RT. 4, BOX 272  
DELAVAN, WI 53115

COMPLIANCE WITH A-E 3, 5(F), 6(A), (E), (C), (D) AND 7 HAS BEEN WAIVED BY THE CLIENT, IN AGREEMENT WITH THE SURVEYOR, AS PERMITTED IN A-E 5.01(B).

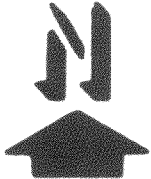

SCALE - 1" = 30'

Ø - IRON PIPE FOUND  
( ) - RECORDED AS

Harold H. Kohl

HAROLD H. KOLP  
WISCONSIN REGISTERED LAND SURVEYOR, S- 187  
DATE APRIL 27, 1984

FLA D-222

216-787-K

2-16 FLAD-222