


KOLB LAND CONSULTING, INC.
LAND SURVEYING • SUBDIVIDING • LAND PLANNING


LAKE GENEVA, WISCONSIN 53147

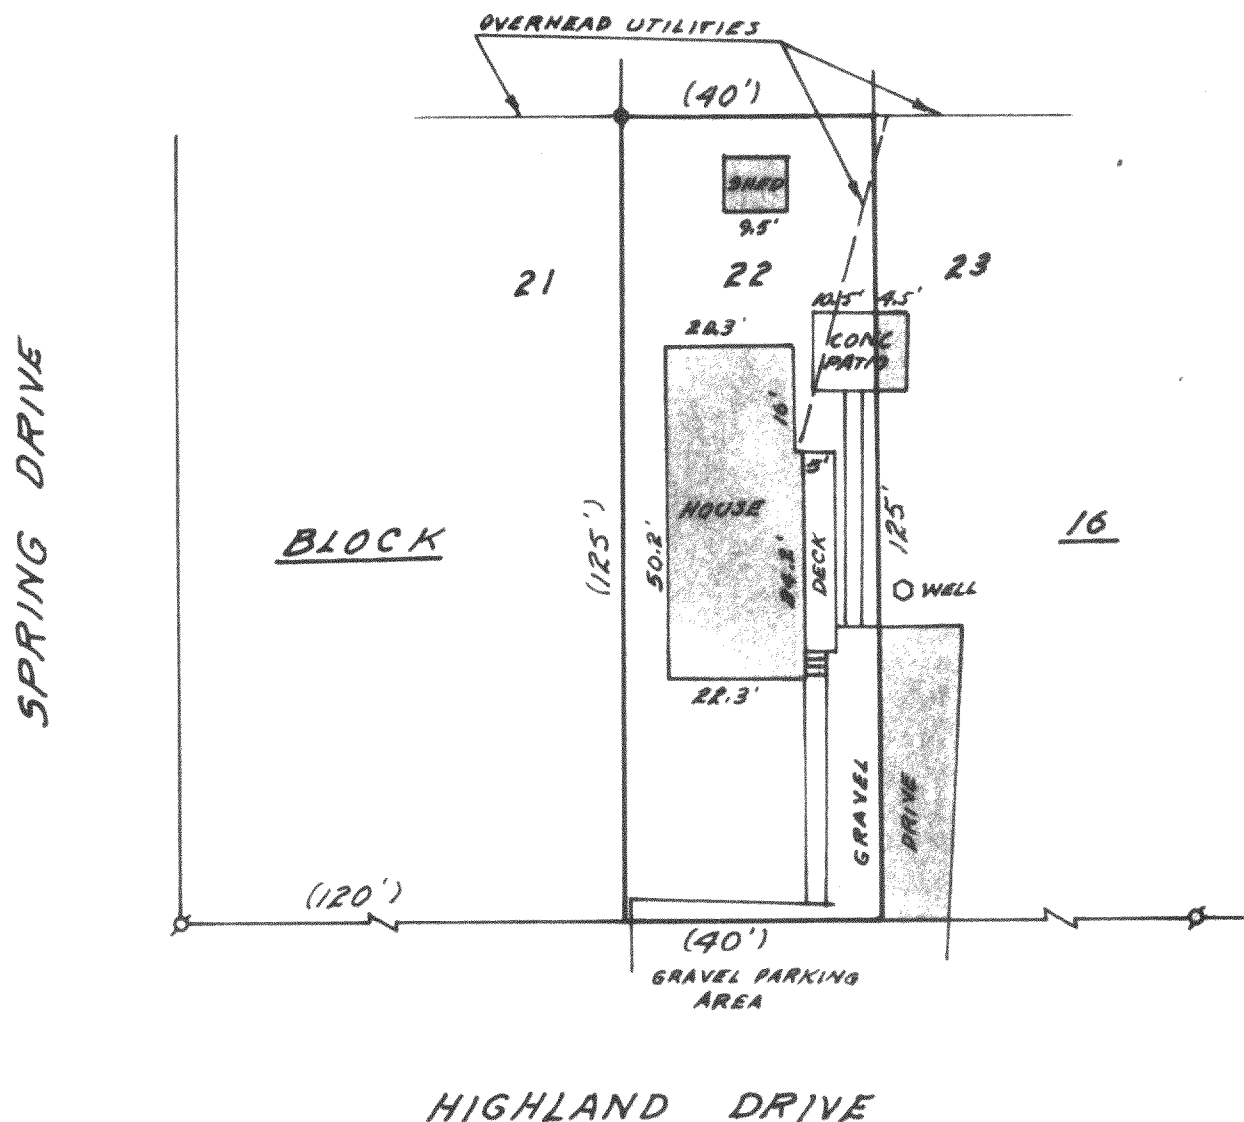

MORTGAGE INSPECTION OF
BLK 16

LOT 22, DELAVAN LAKE VIEW CREST, A SUBDIVISION LOCATED IN SECTION 31, T 2 N, R 16 E, TOWN OF DELAVAN, WALWORTH COUNTY, WISCONSIN

COMPLIANCE WITH A E 3, 5(F), 6(A), (B), (C), (D) AND 7 HAS BEEN WAIVED BY THE CLIENT, IN AGREEMENT WITH THE SURVEYOR, AS PERMITTED IN A-E 5.01(B).

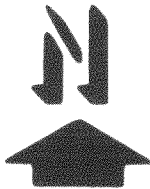

SCALE: 1"=30'

LEGEND
● IRON ROD FOUND
⊗ IRON PIPE FOUND
(3') AS RECORDED

ORDERED BY: ANCHOR SAVINGS & LOAN ASSOCIATION
500 E. WALWORTH AVE.
DELAVAN, WI. 53115

BUYER: RALPH R. CECCHINI
8413 DEMPSTER
NILES, IL. 60648

TAX PARCEL: FDLV-105

Harold H. Kolb
HAROLD H. KOLB

WISCONSIN REGISTERED LAND SURVEYOR, S- 187
DATE APRIL 6, 1984

216-788-K

FDLV-104A