
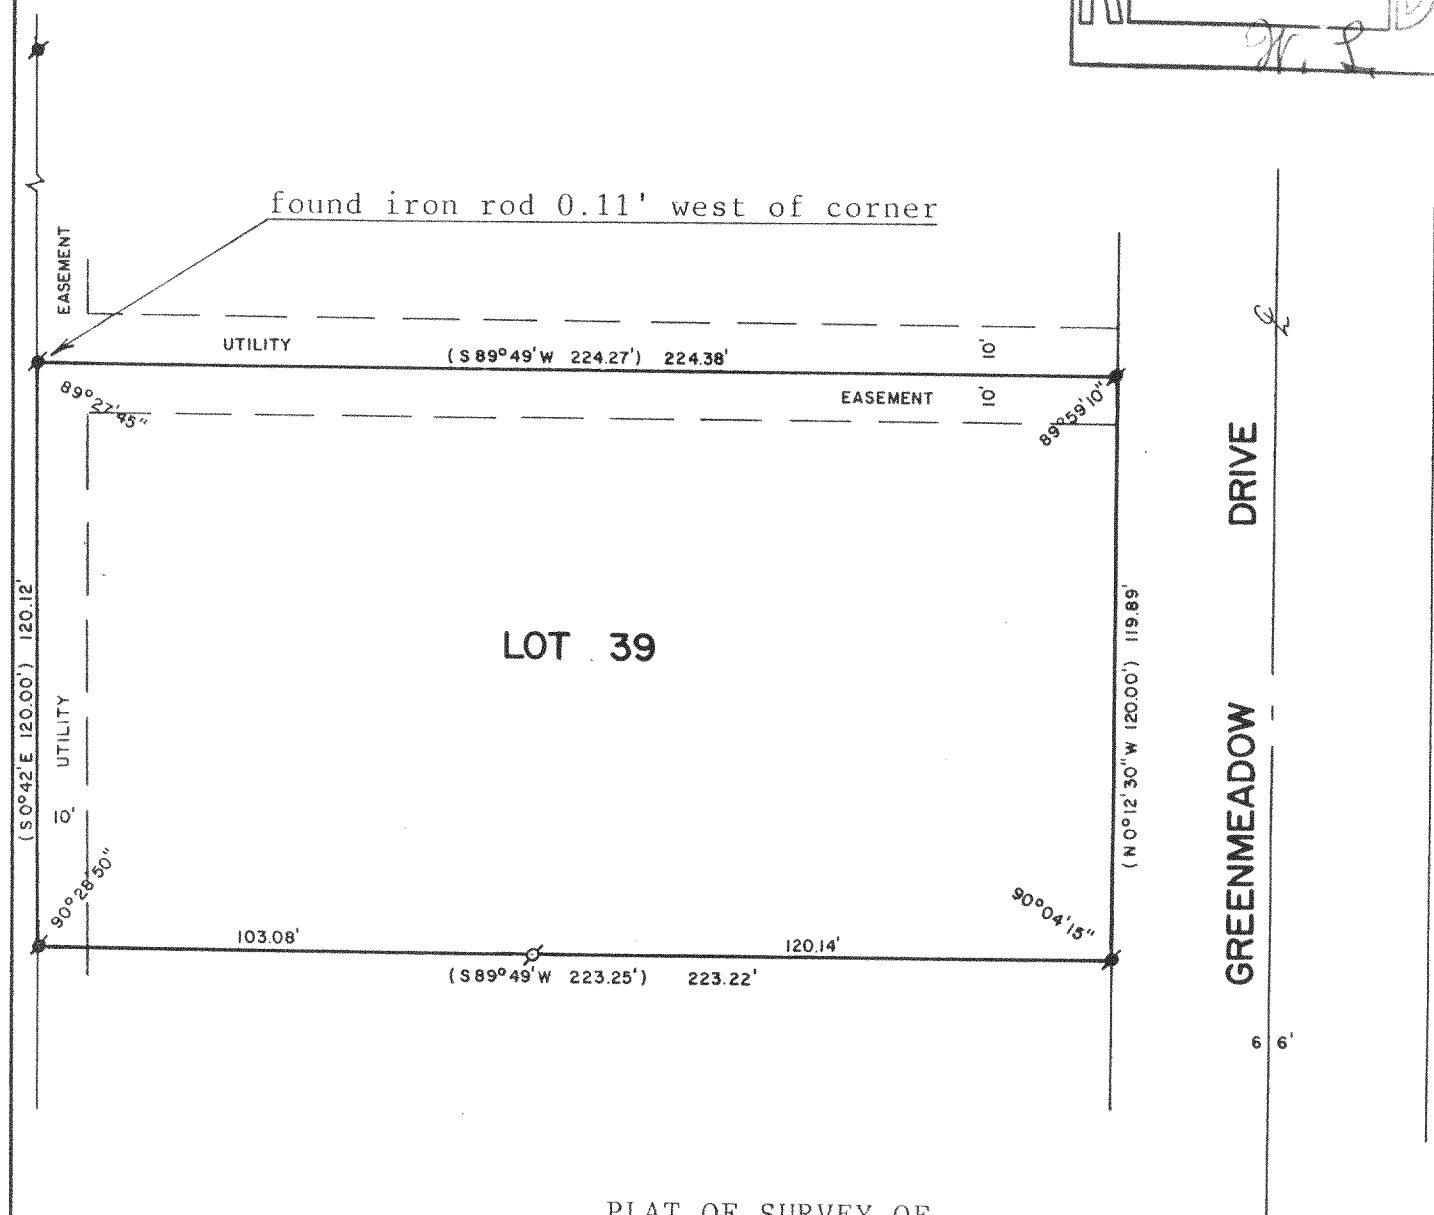




ABELL
SURVEYING & MAPPING
DELAVAN, WISCONSIN 53115

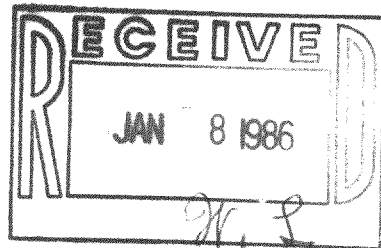

PLAT OF SURVEY OF

LOT 39 OF OAK MEADOW SUBDIVISION, LOCATED IN THE
NORTHEAST 1/4 CF SECTION 29, TOWN 2 NORTH, RANGE
16 EAST, WALWORTH COUNTY, WISCONSIN.

ORDERED BY: KEEFE REAL ESTATE
302 E. WALWORTH AVE.
DELAVAN, WI 53115

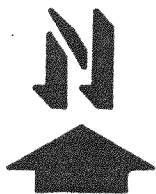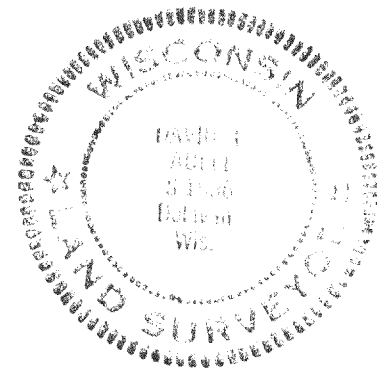

SCALE - 1"=40'

LEGEND

- - IRON ROD FOUND
- ⊗ - IRON PIPE FOUND
- () - RECORDED AS

I, DAVID F. ABELL, DO HEREBY CERTIFY
THAT I HAVE SURVEYED THE PROPERTY
HEREON DESCRIBED ACCORDING TO THE
OFFICIAL RECORDS, AND THAT THE PLAT
HEREON IS A CORRECT REPRESENTATION
OF THE LOT LINES TO THE BEST OF MY
KNOWLEDGE AND BELIEF.

David F. Abell
DAVID F. ABELL
WISCONSIN REGISTERED LAND SURVEYOR, S-1596

DECEMBER 18, 1985
DATE JOB NUMBER - 1285002

FOMS-00039

216-801-A