

RECEIVED
SEP 30 1985
K.L.

KOLB LAND CONSULTING, INC.
LAND SURVEYING • SUBDIVIDING • LAND PLANNING

LAKE GENEVA, WISCONSIN 53147

Found Spike SW Corner
Section 30-2-16

NORTH SHORE DRIVE

Found Witness Monument 155' North of
SE Corner Section 30-2-16 By Ties

4715.02' N 88°19'50"E 100.00' (400') 399.70' S 1°13'25"E 155'

25.00' 100.00' 1109.49' 799.69' N 1°46'55"W 854.12' 1087.12' S 1°46'55"E

2 & 10' Wide Drive

Garage

Shed
38.2'
37.2'
House

S 71°42'20"W 62.55'

S 67°03'10"W 42.93'


DELAVAN LAKE

PLAT OF SURVEY OF

LOT 2 OF ARNOLD'S WOODS, LOCATED IN THE NORTH-
EAST ¼ OF SECTION 31, TOWN 2 NORTH, RANGE 16
EAST, WALWORTH COUNTY, WISCONSIN, CONTAINING
2.52 ACRES, MORE OR LESS.

ORDERED BY: MATT BRANDER
FOR: RICHARD L. CORWIN
811 W. HILLGROVE AVE.
LAGRANGE, IL 60525

NOTE: BEARINGS ARE TIED TO THE WISCONSIN COORDINATE
SYSTEM - SOUTH ZONE.

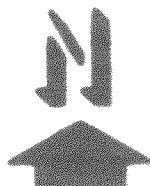


SCALE - 1"=100'

LEGEND

- - IRON PIPE SET
- - CONCRETE MONUMENT FOUND
- () - RECORDED AS

I HEREBY CERTIFY THAT I HAVE SURVEYED THE
ABOVE DESCRIBED PROPERTY AND THAT THE ABOVE
MAP IS A TRUE REPRESENTATION THEREOF AND
SHOWS THE SIZE AND LOCATION OF THE PROPERTY,
ITS EXTERIOR BOUNDARIES, THE LOCATION OF ALL
VISIBLE STRUCTURES AND PRINCIPAL DIMENSIONS
OF ALL PRINCIPAL BUILDINGS THEREON, BOUNDARY
FENCES, APPARENT EASEMENTS, ROADWAYS AND
VISIBLE ENCROACHMENTS, IF ANY, TO THE BEST
OF MY KNOWLEDGE AND BELIEF.
THIS SURVEY IS MADE FOR THE USE OF THE
PRESENT OWNERS OF THE PROPERTY, AND ALSO
THOSE WHO PURCHASE, MORTGAGE, OR GUARANTEE
THE TITLE THERETO WITHIN ONE (1) YEAR FROM
DATE HEREOF.

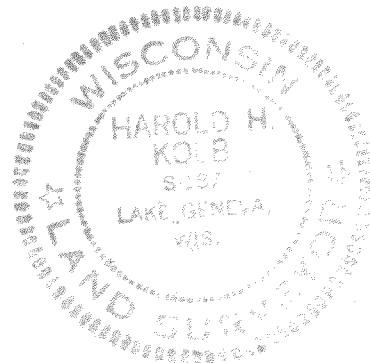

Harold H. Kolb
HAROLD H. KOLB

WISCONSIN REGISTERED LAND SURVEYOR, S-187

DATE January 30, 1985

FAW-2

216-812-R