
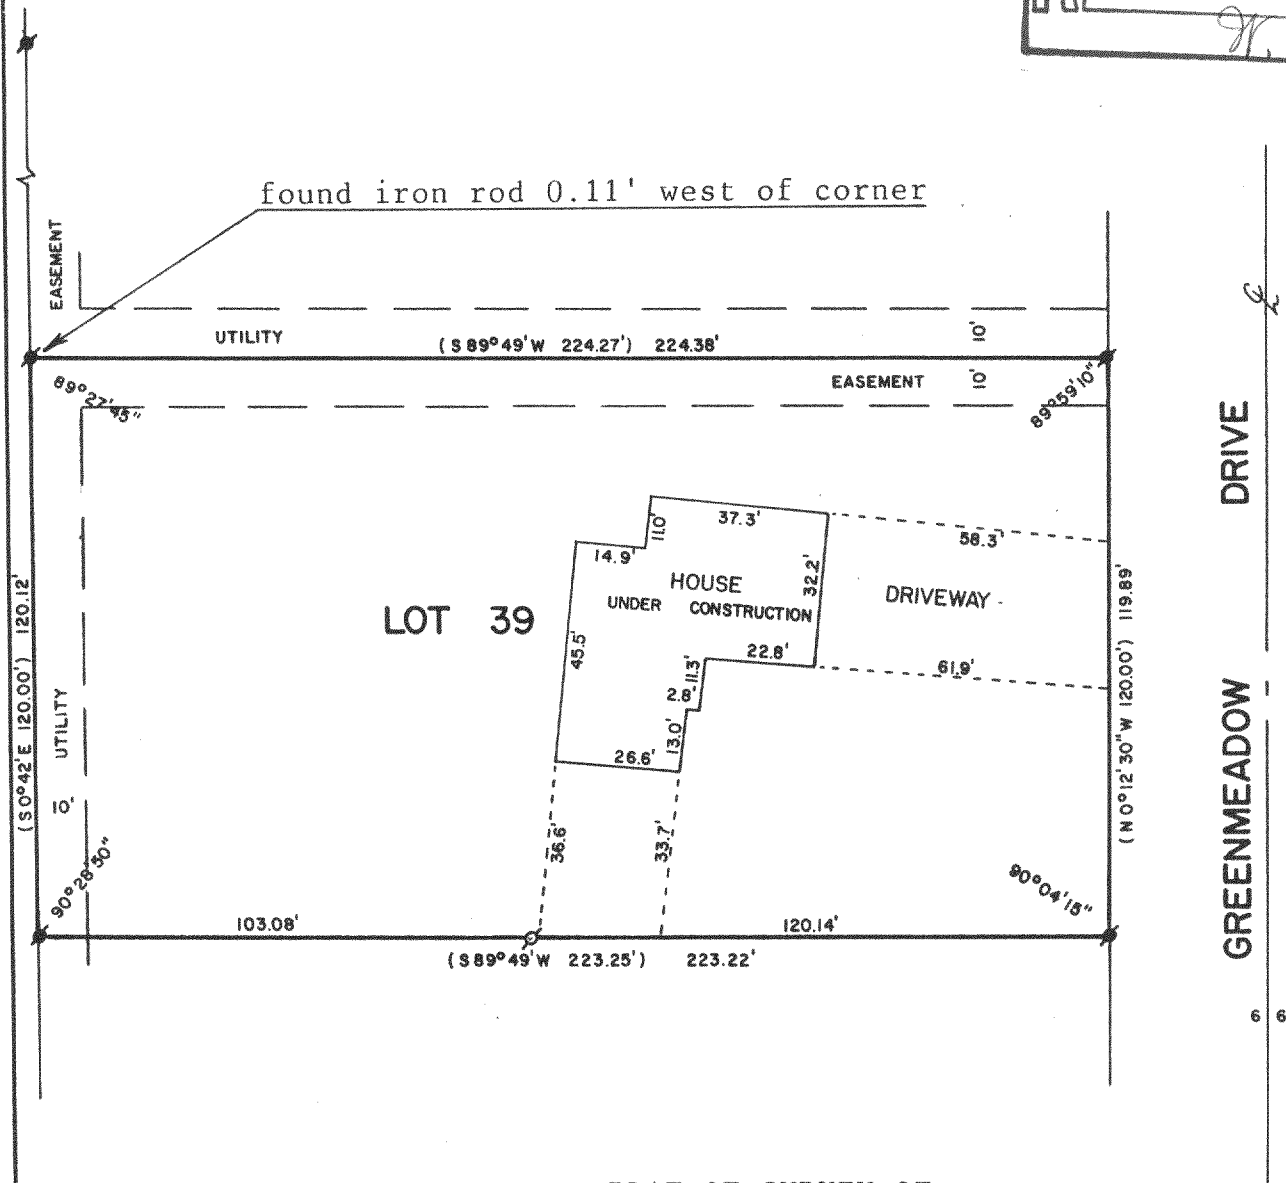




ABELL  
SURVEYING & MAPPING  
DELAVAN, WISCONSIN 53115

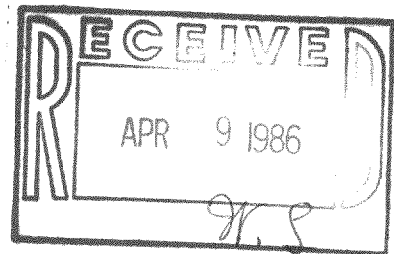

PLAT OF SURVEY OF

LOT 39 OF OAK MEADOW SUBDIVISION, LOCATED IN THE  
NORTHEAST 1/4 OF SECTION 29, TOWN 2 NORTH, RANGE  
16 EAST, WALWORTH COUNTY, WISCONSIN.

ORDERED BY: KEEFE REAL ESTATE  
302 E. WALWORTH AVE.  
DELAVAN, WI 53115

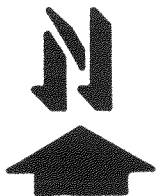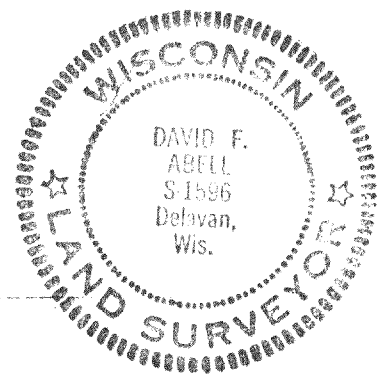

SCALE - 1"=40'

LEGEND

- - IRON ROD FOUND
- ⊗ - IRON PIPE FOUND
- ( ) - RECORDED AS

I, DAVID F. ABELL, DO HEREBY CERTIFY  
THAT I HAVE SURVEYED THE PROPERTY  
HEREON DESCRIBED ACCORDING TO THE  
OFFICIAL RECORDS, AND THAT THE PLAT  
HEREON IS A CORRECT REPRESENTATION  
OF THE LOT LINES TO THE BEST OF MY  
KNOWLEDGE AND BELIEF.

*David F. Abell*  
DAVID F. ABELL  
WISCONSIN REGISTERED LAND SURVEYOR, S-1596

REVISED: MARCH 12, 1986

ORDERED BY: ANCHOR SAVINGS &  
LOAN  
DELAVAN, WI 53115

DECEMBER 18, 1985

DATE JOB NUMBER - 1285002