
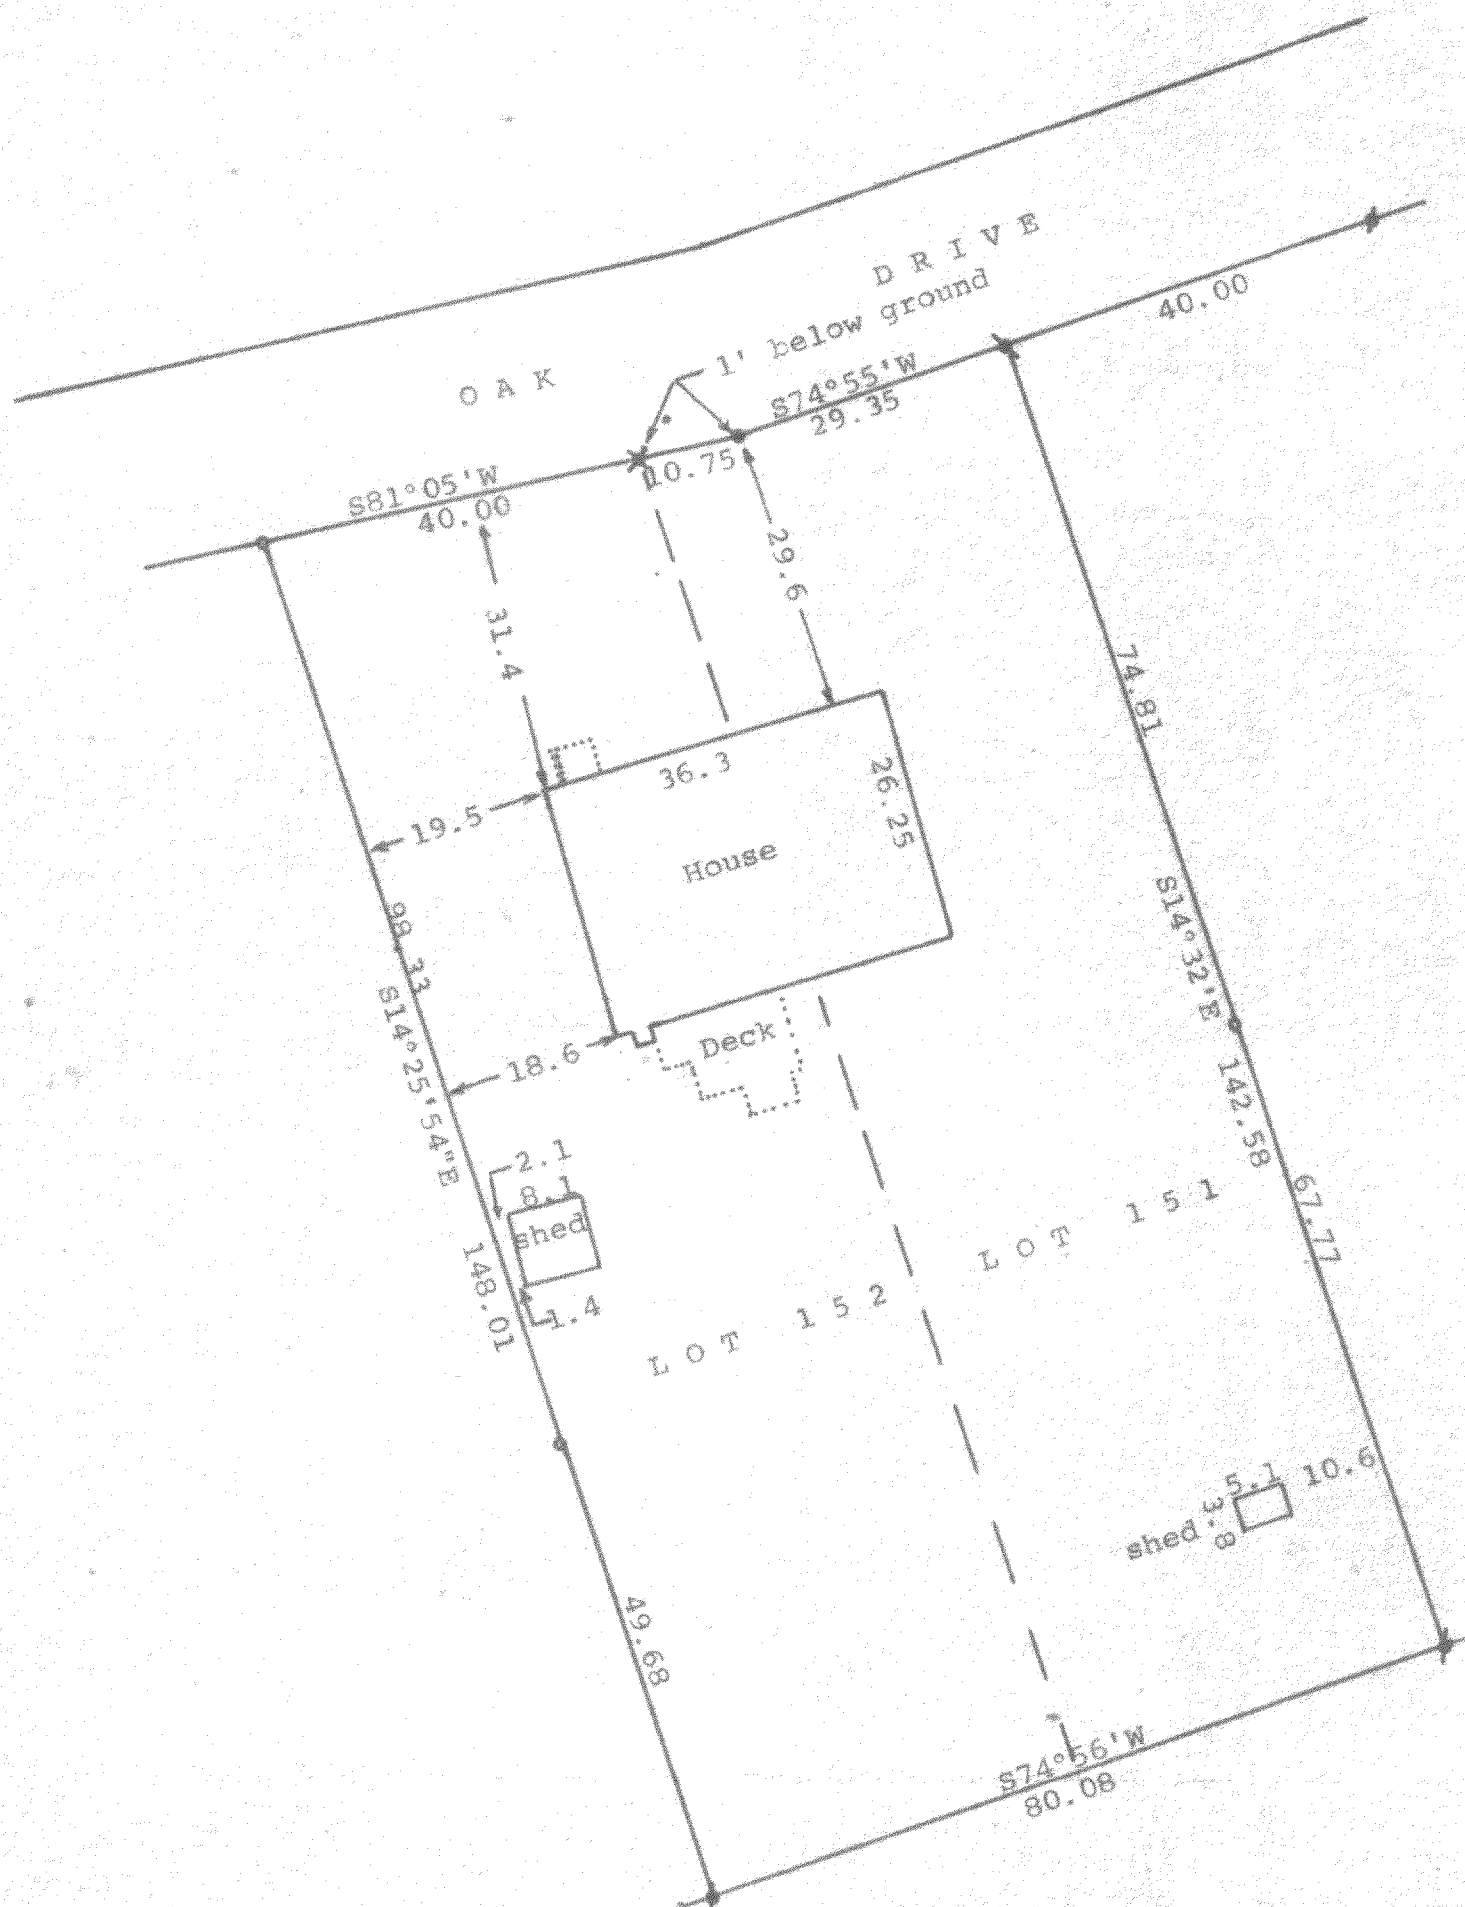


DUNHAM SURVEYING, S. C.
SURVEYING & SUBDIVIDING
DELAVER, WISCONSIN 53115

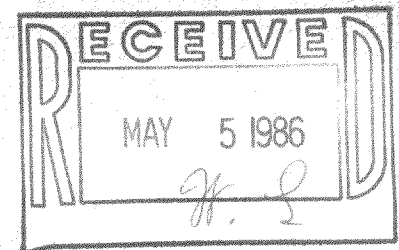

N

Scale - 1" = 20'

- = 3/4" X 24" Iron Pipe Set
- = Concrete Monument Found
- = 1/2" Square Iron Rod Found
- = 1 1/4" Iron Pipe Found

Survey ordered by: Century 21 Skandia Realty Inc
312 South 7th Street
Delavan, WI 53115

• = 1 1/4" X 24" iron Pipe Set

Bearings referenced to the assumed bearing of
S74°55'W along the northerly line of Lot 151

STATE OF WISCONSIN) SS
COUNTY OF WALWORTH)

I, George T. Dunham, Surveyor, certify that I have surveyed
the property described as follows:

Lots 151 and 152 of Krumhaar's 2nd Addition to Ravenswood,
a subdivision located in Section 31, T 2 N, R 16 E, Walworth
County, Wisconsin;

and that the above map is a true representation thereof and shows the
size and location of the property, its exterior boundaries, the location
of all visible structures and dimensions of all principal buildings
thereon, boundary fences, apparent easements, roadways and visible
encroachments, if any, and that I have surveyed the property hereon
described according to the official records, to the best of my knowledge
and belief.

April 9, 1986

George T. Dunham
George T. Dunham, Surveyor

