


DUNHAM SURVEYING, S.C.
SURVEYING & SUBDIVIDING
DELAVER, WISCONSIN 53115

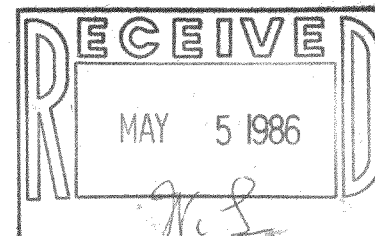

N

Scale - 1" = 20'

• = 3/4" Iron Pipe Found
• = 1" Iron Pipe Found

Bearings referenced to the northeasterly line of the lots with the assumed bearing of N48°00'00"W.

Owner: Mike Papcke
R. 4, Box 438C
Delavan, WI 53115
(0.00) = recorded distance



STATE OF WISCONSIN) SS
COUNTY OF WALWORTH)

I, George T. Dunham, Surveyor, certify that I have surveyed the property described as follows:

Lots 21 and 22 in Block 7 in South Shore Manor, a subdivision located in the Southeast Fractional 1/4 of Section 32, T 2 N, R 16 E, Walworth County, Wisconsin,

and that the map shown above is a true representation thereof and shows the size and location of the property, its exterior boundaries, the location of all visible structures and dimensions of all principal buildings thereon, boundary fences, apparent easements, roadways and visible encroachments, if any, and that I have surveyed the property hereon described according to the official records, to the best of my knowledge and belief.

October 2, 1985
Revised January 9, 1986

George T. Dunham
George T. Dunham, Surveyor

