

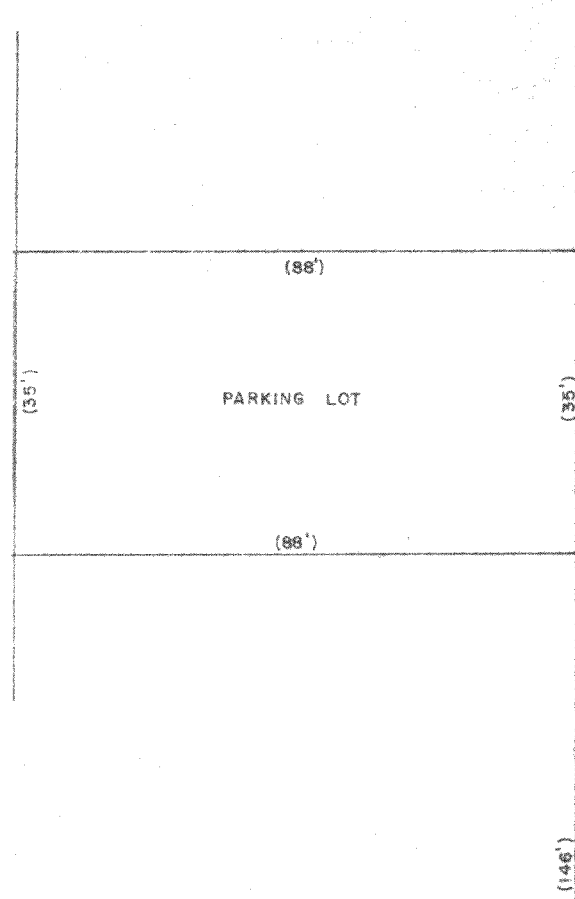


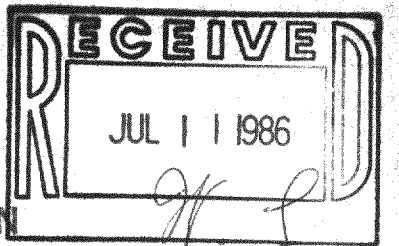

PUBLIC ROAD


NOTE: THERE IS A CONCRETE SIDEWALK
RUNNING NORTH AND SOUTH ALONG THE
WESTERLY LINE OF LOTS 1, 3, 5, 7,
9 AND 11.

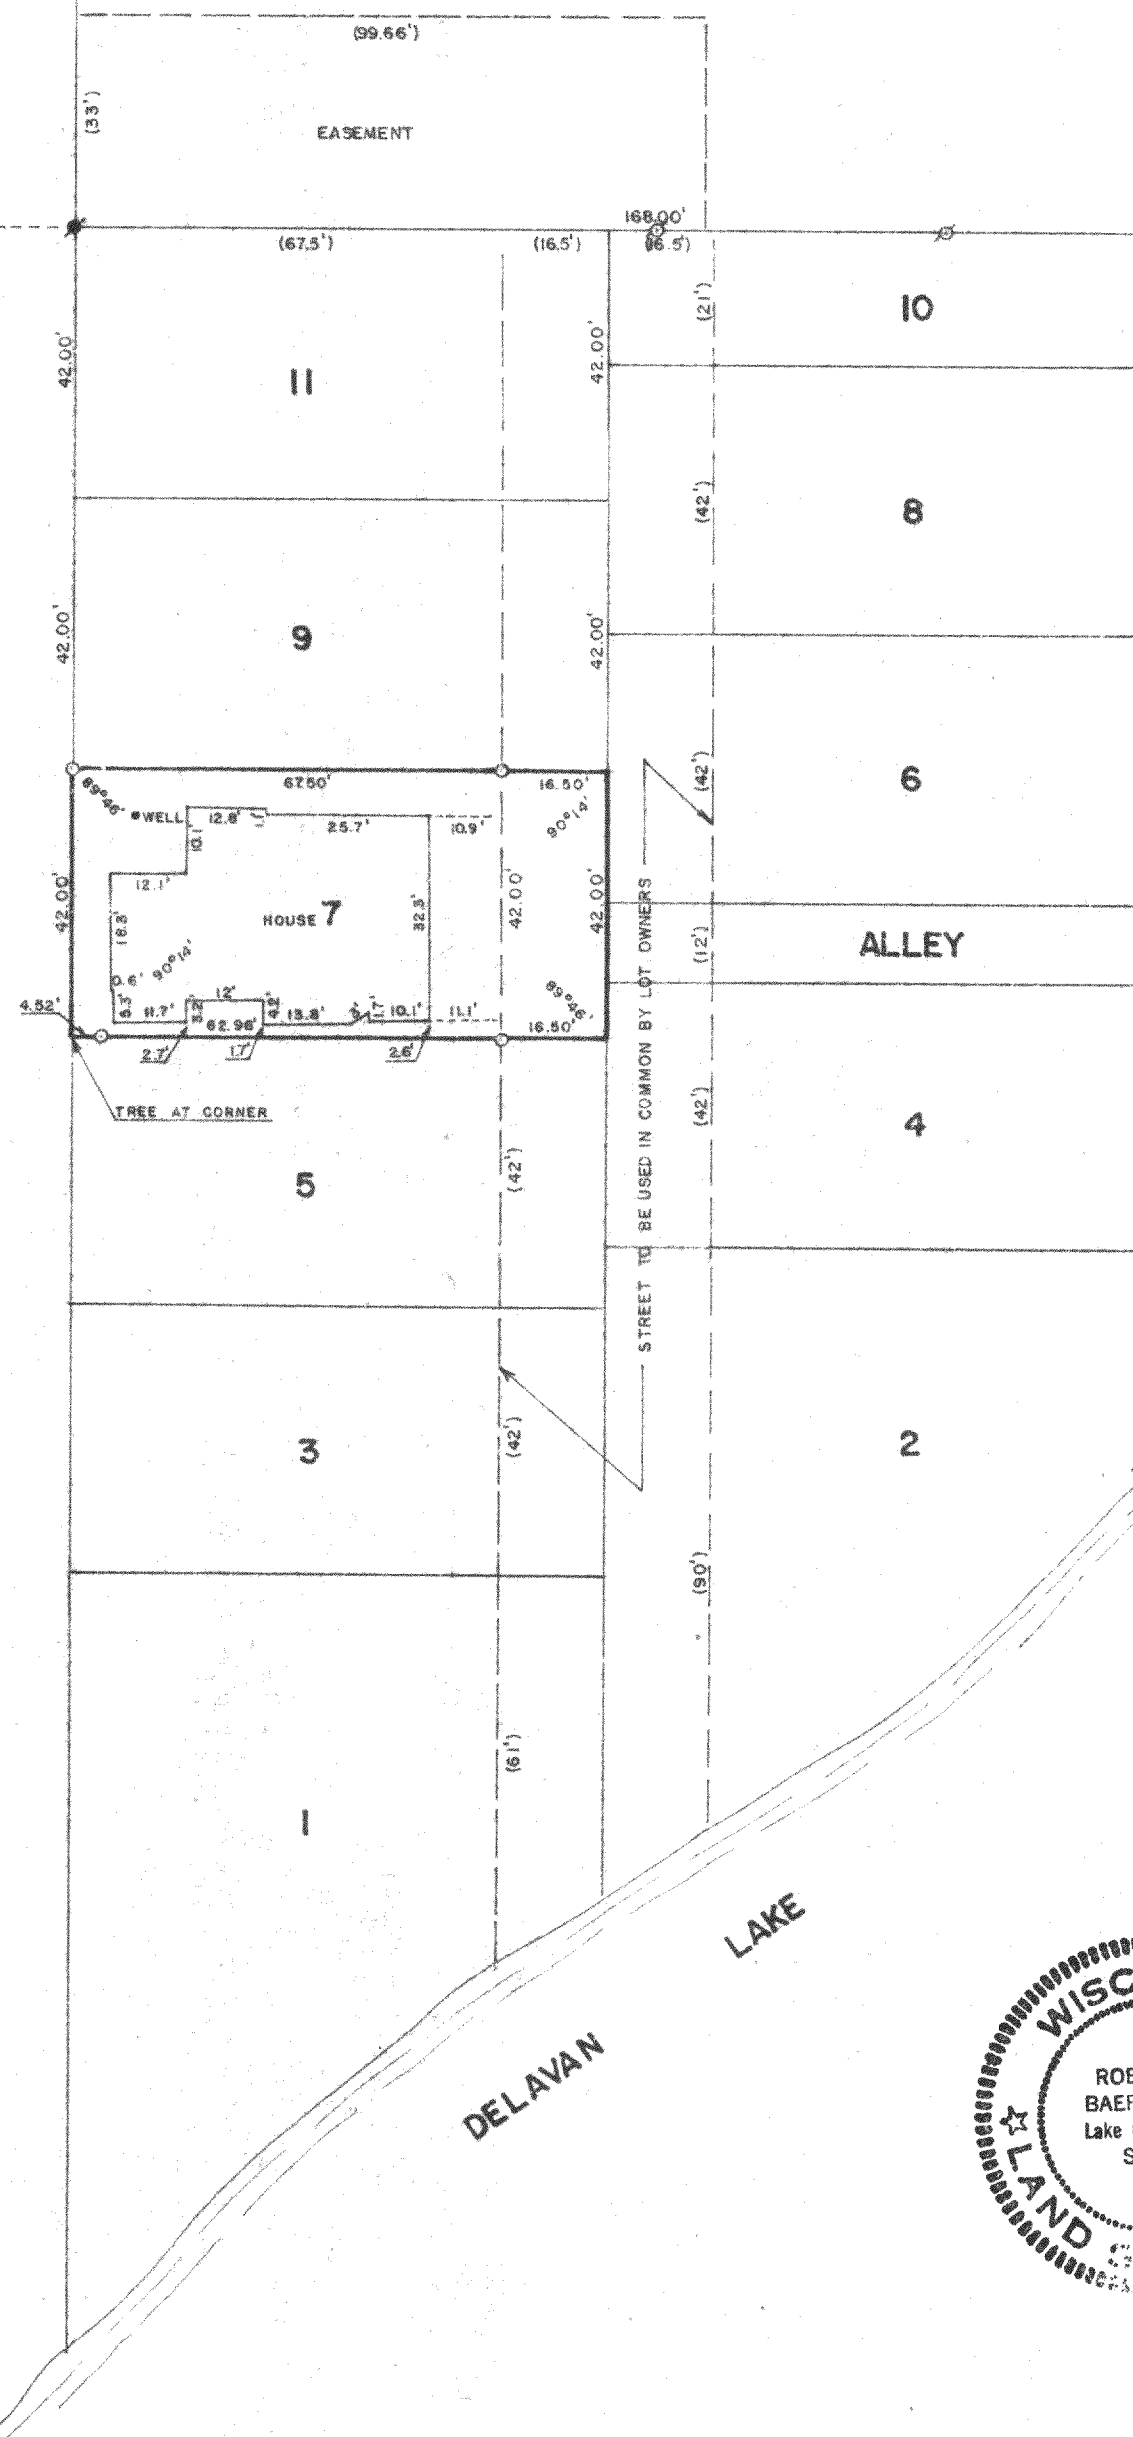

PLAT OF SURVEY OF


LOT 7 OF ROCKFORD COLONY, A SUBDIVISION
LOCATED IN THE NORTHWEST 1/4 OF SECTION
28, T 2 N, R 16 E, WALWORTH COUNTY,
WISCONSIN.

ORDERED BY: JOHN BRITT
C/O OTTO & SNYDER
3 SOUTH PROSPECT-SUITE 6
PARK RIDGE, ILLINOIS 60068

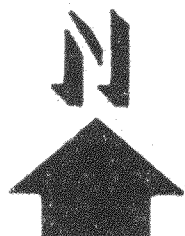

SCALE: 1"=30'

- o - IRON PIPE FOUND
- o - IRON ROD SET
- - CONCRETE MONUMENT FOUND
- () - RECORDED AS

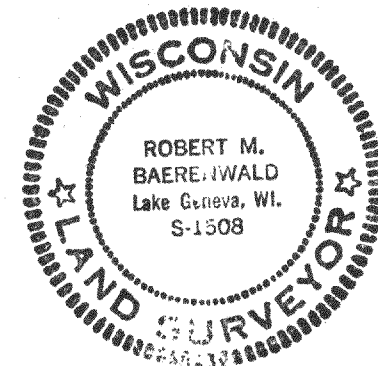

I, ROBERT M. BAERENWALD, DO HEREBY CERTIFY THAT I
HAVE SURVEYED THE PROPERTY HEREON DESCRIBED ACCORDING
TO THE OFFICIAL RECORDS AND THAT THE PLAT HEREON IS A
CORRECT REPRESENTATION OF THE PROPERTY LINES TO THE
BEST OF MY KNOWLEDGE AND BELIEF.

Robert M. Baerenwald
ROBERT M. BAERENWALD
WISCONSIN REGISTERED LAND SURVEYOR, S-1508

DATE *June 27, 1986*
JOB NO. 0601