


RECEIVED
AUG 19 1986
H. I.

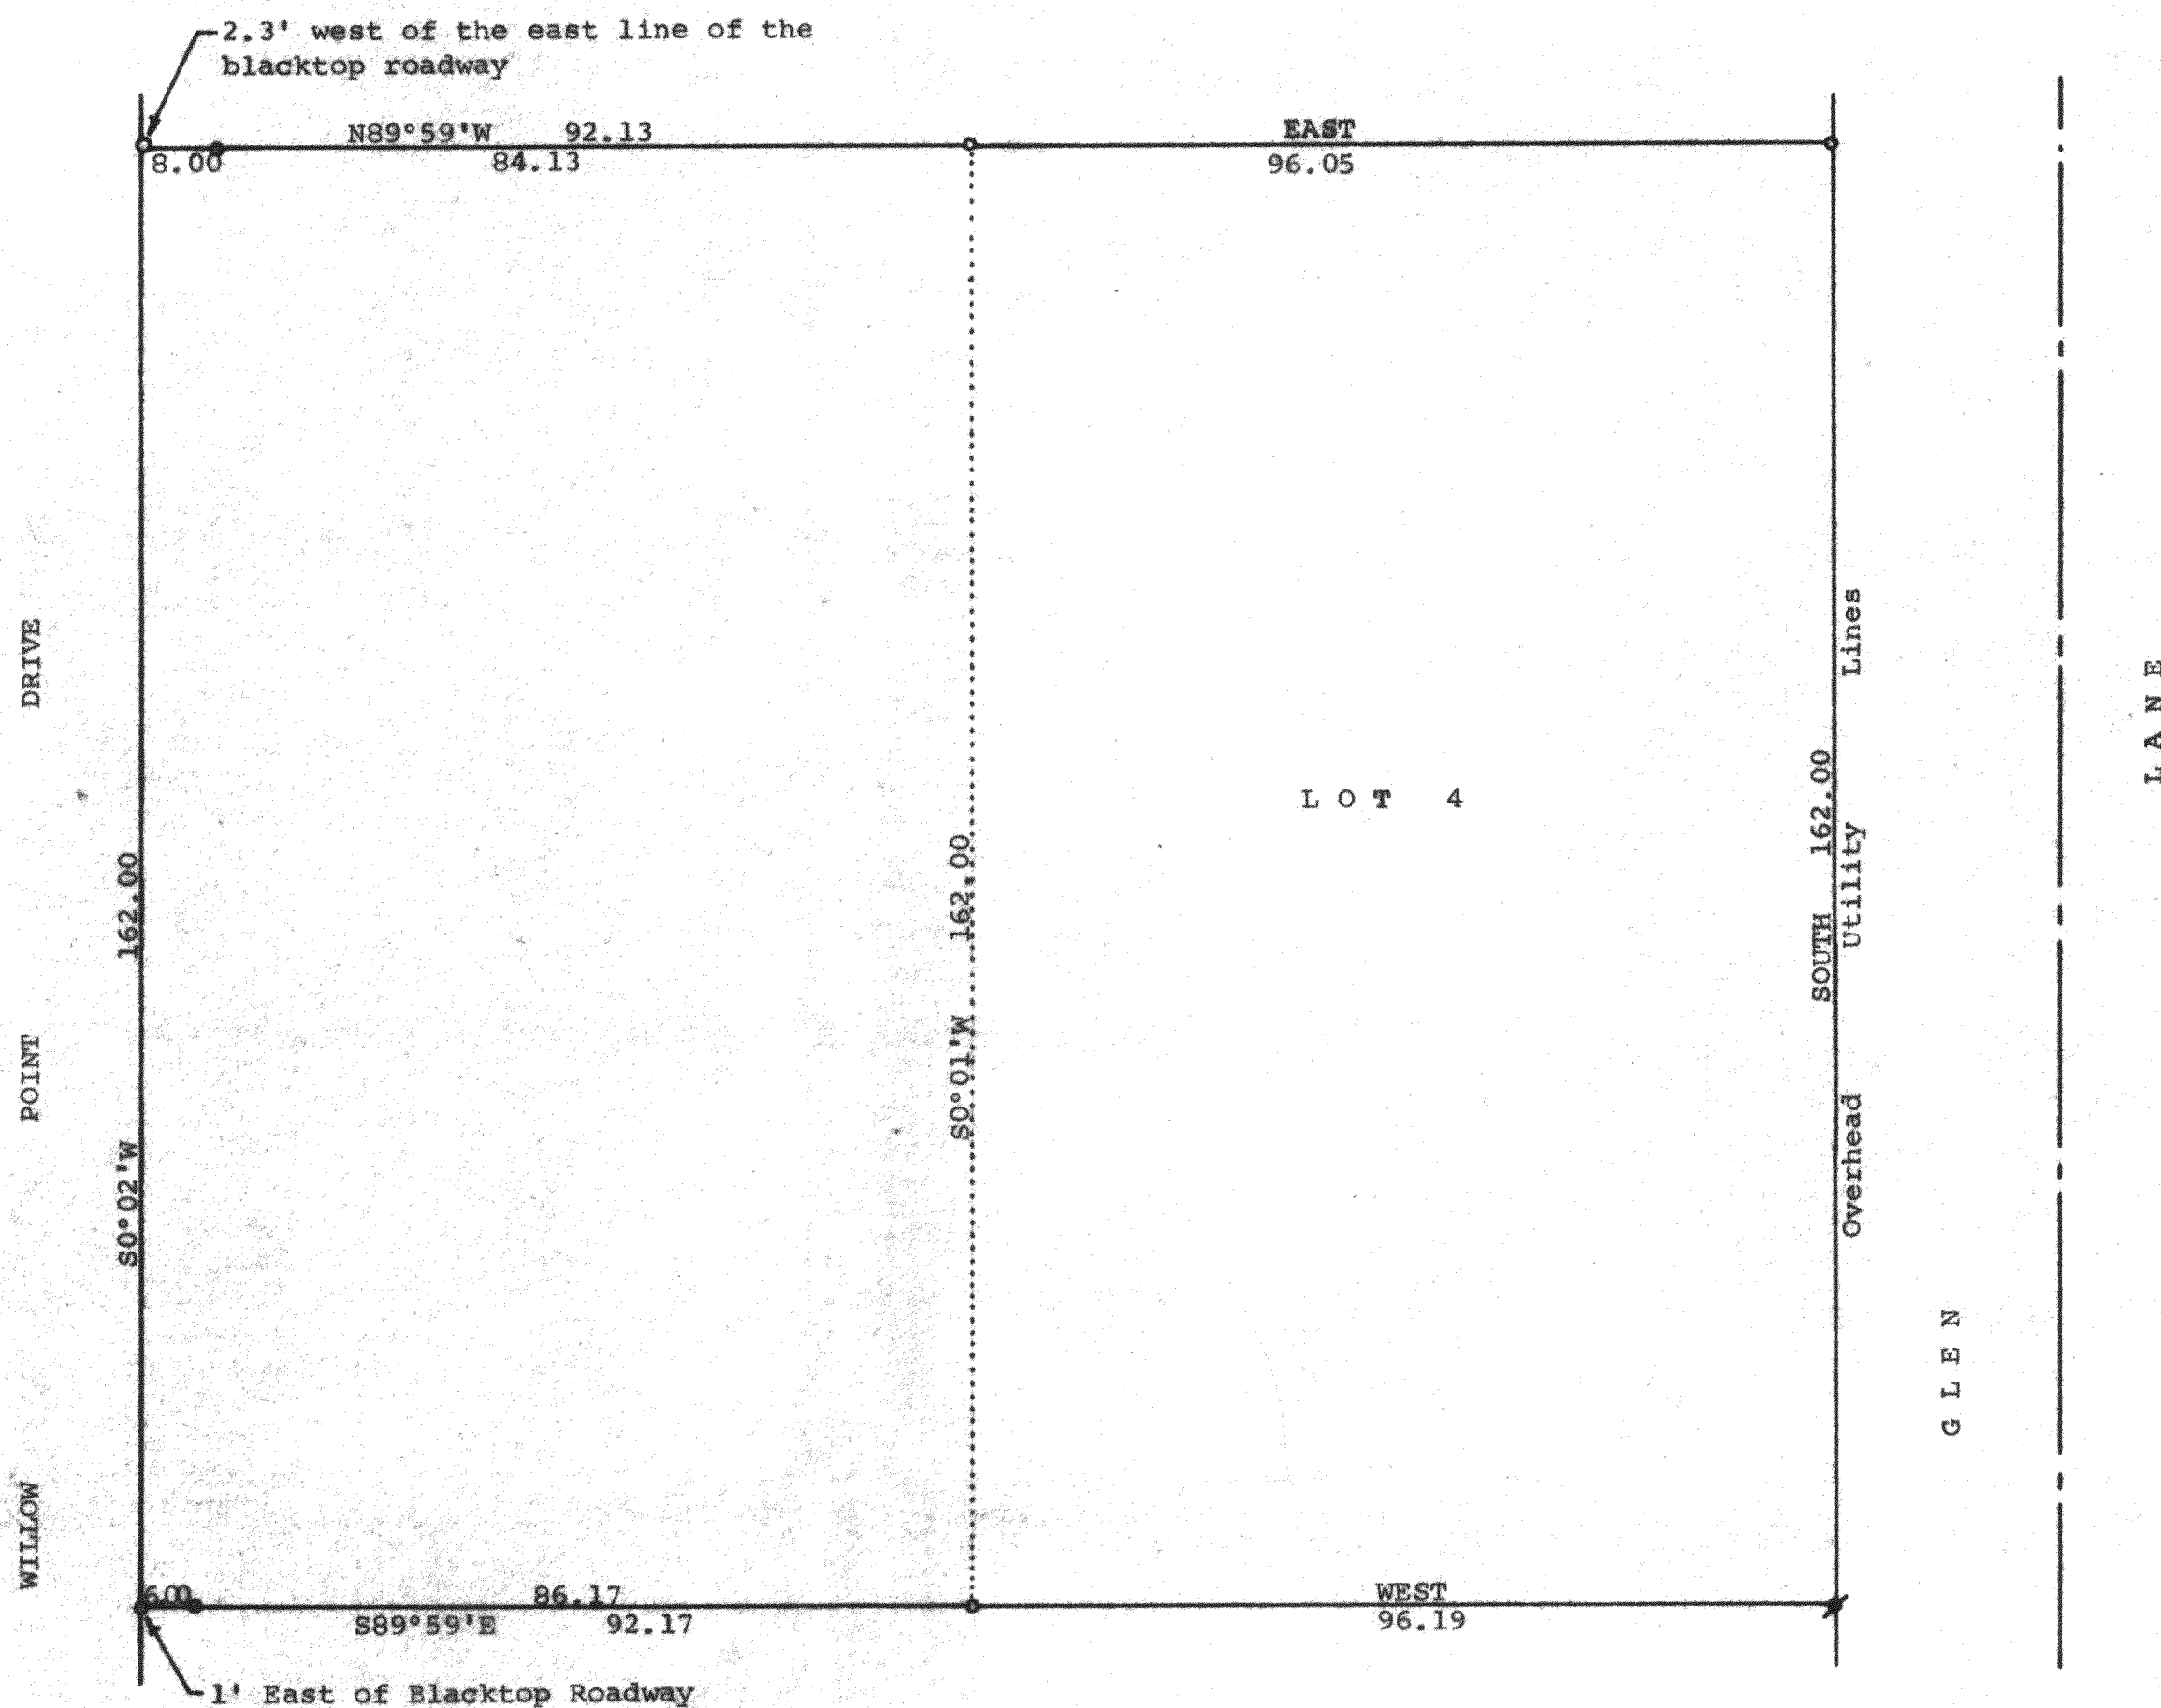

Scale - 1" = 20'
 o = 3/4" Iron Pipe Found
 x = 1" Iron Pipe Set
 Bearings used are those
 of record
 Survey ordered for:
 Biggan, Cowan, Marquardt
 & Lunding
 Suite 2810
 180 N. LaSalle Street
 Chicago, IL 60601

STATE OF WISCONSIN)
COUNTY OF WALWORTH) ss

I, George T. Dunham, Surveyor, certify that I have surveyed the property described as follows:

A parcel of land located in the Southeast $\frac{1}{4}$ of Section 29, T 2 N, R 16 E, Walworth County, Wisconsin, described as follows: Beginning at the southwest corner of Lot 4 of the Re-Subdivision of Lots 1 & 3 of Glen Eyrie; thence N0°01'E along the west line of said Lot 4, 162.00 feet; thence N89°59'W 92.13 feet to the east line of Willow Point Drive; thence S0°02'W along said east line 162.00 feet; thence S89°59'E 92.17 feet to the place of beginning.

ALSO Lot 4 of the Re-Subdivision of Lots 1 & 3 of Glen Eyrie, a subdivision located in the Town of Delavan, Walworth County, Wisconsin, and that the map shown above is a true representation thereof and shows the size and location of the property, its exterior boundaries, the location of all visible structures and dimensions of all principal buildings thereon, boundary fences, apparent easements, roadways and visible encroachments, if any, and that I have surveyed the property hereon described according to the official records, to the best of my knowledge and belief.

August 29, 1984

August 29, 1984

George T. Dunham
George T. Dunham, Surveyor

