


DUNHAM SURVEYING, S.C.
SURVEYING & SUBDIVIDING
DELAVER, WISCONSIN 53115

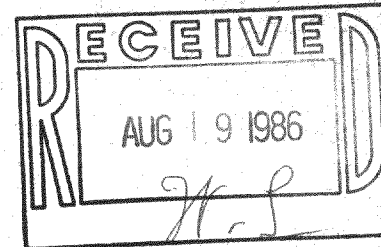

Scale - 1" = 20'
● = 1 1/2" Iron Pipe Found
▲ = 3/4" Iron Pipe Found
○ = 1 1/4" X 24" Iron Pipe Set
● = 1/2" X 24" Iron Pipe Set
▲ = 3/4" X 24" Iron Pipe Set
— = Fence Line

Bearings referenced to the northwesterly line
of South Shore Drive with the recorded bear-
ing of N49°E
Survey ordered by: The Rauland Agency
118 Kenosha
Walworth, WI 53184

STATE OF WISCONSIN)
COUNTY OF WALWORTH) SS

I, George T. Dunham, Surveyor, certify that I have surveyed
the property described as follows:

The Southwesterly 1/2 of Lot 13 of The Harrington Subdivision
located in Fractional Section 27; T 2 N, R 16 E, Walworth
County, Wisconsin,

and that the map shown hereon is a true representation thereof and shows
the size and location of the property, its exterior boundaries, the location
of all visible structures and dimensions of all principal buildings thereon,
boundary fences, apparent easements, roadways and visible encroachments, if
any, and that I have surveyed the property hereon described according to the
official records, to the best of my knowledge and belief.
August 12, 1986,

George T. Dunham
George T. Dunham, Surveyor

