


DUNHAM SURVEYING, S.C.
SURVEYING & SUBDIVIDING
DELAVAN, WISCONSIN 53115

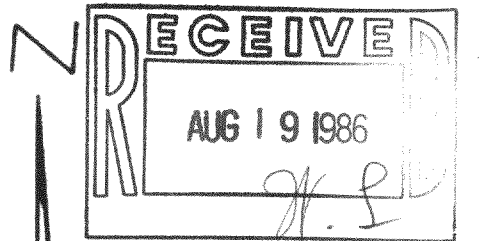

Scale - 1" = 10'

X = 60 Penny Spike on NW side of
60" Willow Tree - in root
P = 3/4" Iron Pipe Found
Q = 1" Iron Pipe Found

Bearings referenced to the northeasterly line
Lot 28 with the assumed bearing of N49°54'W

Owner: Martin Miller
2328 Lake Shore Drive
Delavan, WI 53115

