



ABELL  
SURVEYING & MAPPING  
DELAVER, WISCONSIN 53115  
414-728-6737

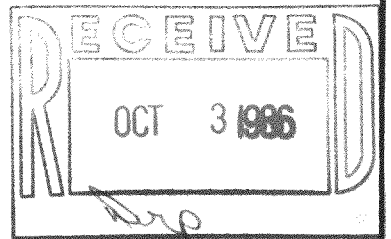

PLAT OF SURVEY OF

THE SOUTHWESTERLY 40 FEET OF LOT 5  
AND THE NORTHEASTERLY 35 FEET OF LOT 6,  
BAILEY SUBDIVISION, T2N, R16E, WALWORTH  
COUNTY, WISCONSIN.

ORDERED BY: THE RAULAND AGENCY  
607 E. WALWORTH AVE.  
DELAVER, WI 53115

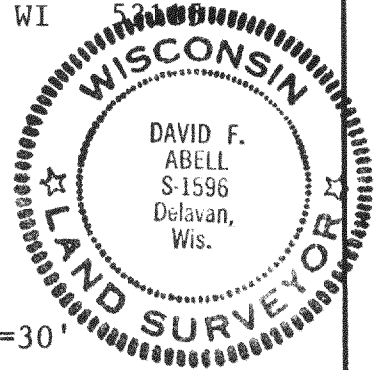

SCALE - 1"=30'

LEGEND

- ♂ - IRON PIPE FOUND
- - CONCRETE MONUMENT FOUND
- ( ) - RECORDED AS

NOTE: THERE IS A CHAIN LINK FENCE  
WHICH RUNS JUST SOUTH OF THE SOUTH LINE  
OF THIS PROPERTY. THE FENCE BELONGS  
TO THE PEOPLE TO THE SOUTH.

I HEREBY CERTIFY THAT I HAVE SURVEYED THE  
ABOVE DESCRIBED PROPERTY AND THAT THE  
ABOVE MAP IS A TRUE REPRESENTATION THERE-  
OF AND SHOWS THE SIZE AND LOCATION OF THE  
PROPERTY, ITS EXTERIOR BOUNDARIES, THE  
LOCATION OF ALL PRINCIPAL BUILDINGS THERE-  
ON, BOUNDARY FENCES, APPARENT EASEMENTS,  
ROADWAYS, AND VISIBLE ENCROACHMENTS, IF  
ANY, TO THE BEST OF MY KNOWLEDGE AND BE-  
LIEF.

THIS SURVEY IS MADE FOR THE USE OF THE  
PRESENT OWNERS OF THE PROPERTY, AND ALSO  
THOSE WHO PURCHASE, MORTGAGE, OR GUARANTEE  
THE TITLE THERETO WITHIN ONE (1) YEAR  
FROM DATE HEREOF.

*David F. Abell*

DAVID F. ABELL  
WISCONSIN REGISTERED LAND SURVEYOR, S-1596

DATE Sept. 2, 1986 JOB NUMBER - 86042

