


PLAT OF SURVEY


of  
Lots 7 and 8 of block 1 of Inlet Oaks Subdivision  
No. 3, Walworth County, Wisconsin.

Surveyed for: Charles Simmons  
Rt. 2  
Delevan, WI. 53115

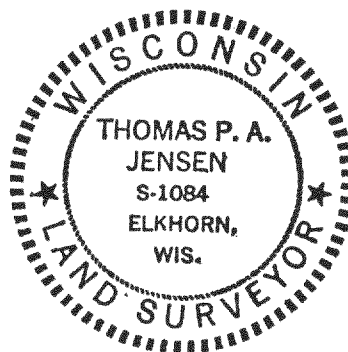

Surveyed by:

Jensen Surveying & Mapping S.C.  
45 S. Wisconsin St. P.O. Box 322  
Elkhorn, Wisconsin. 53121  
(414) 723-3434

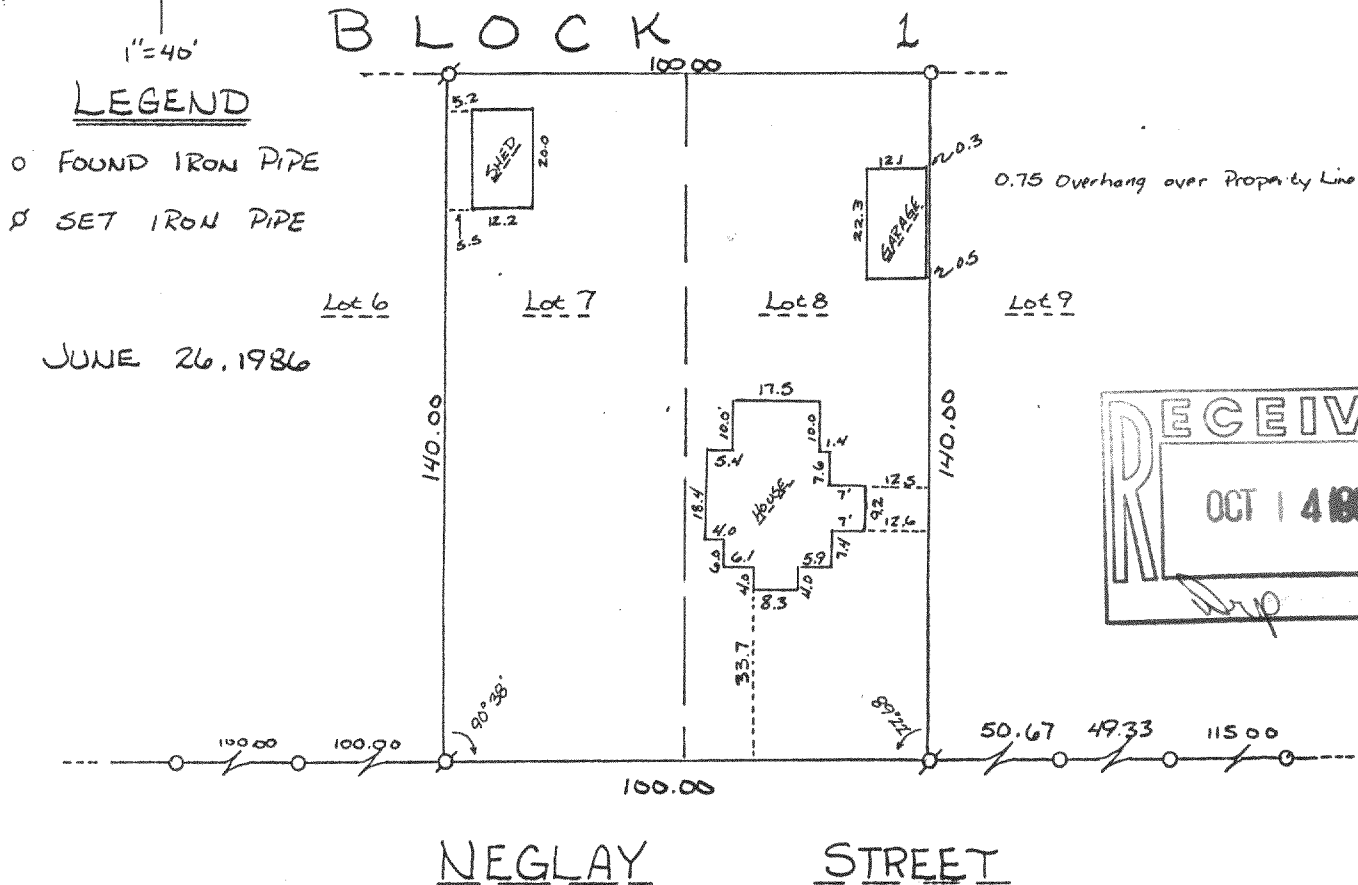

I, Thomas P.A. Jensen, Wisconsin Registered Land Surveyor, do hereby certify that this survey was performed by me, or under my direction, in full compliance with the owner's/agent's instructions and chapter A-E 5 of the Wisconsin Administrative Code "Minimum Standards For Property Surveys"; and that this map is an accurate representation thereof to the best of my knowledge and belief.

Thomas P.A. Jensen S-1084  
Jensen Surveying & Mapping S.C.  
45 S. Wisconsin St.  
Elkhorn, Wisconsin. 53121  
(414) 723-3434

1986.055 X

216-879