



ABELL
SURVEYING & MAPPING
DELAVAN, WISCONSIN 53115
414-728-6737

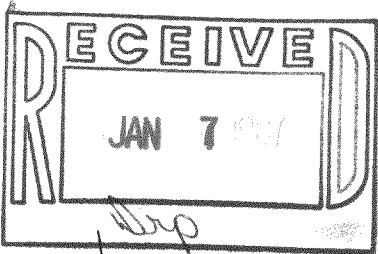

ORDERED BY: CENTURY 21-SKANDIA REALTY
312 S. 7th STREET
DELAVAN, WI 53115

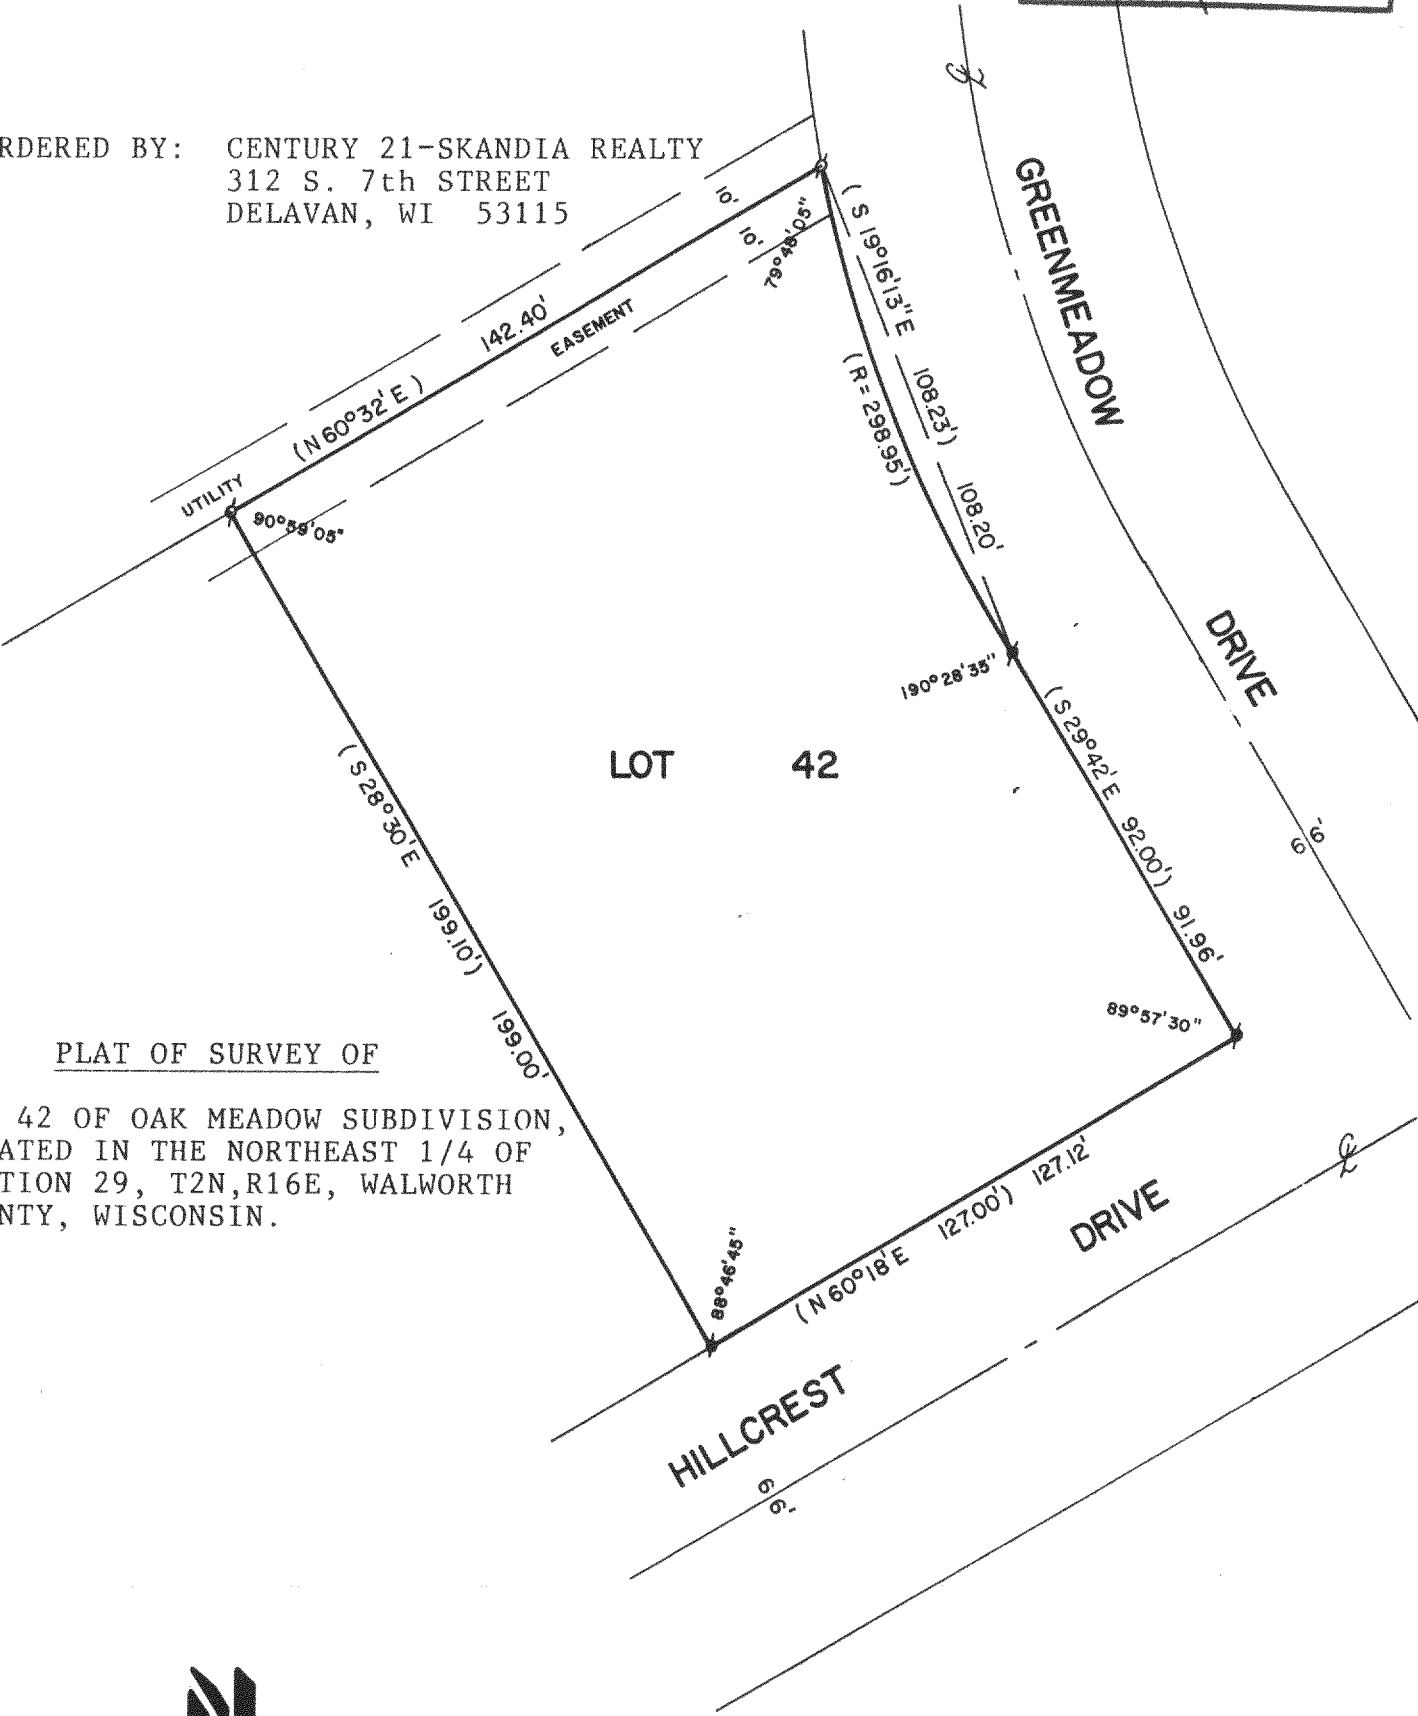

PLAT OF SURVEY OF

LOT 42 OF OAK MEADOW SUBDIVISION,
LOCATED IN THE NORTHEAST 1/4 OF
SECTION 29, T2N,R16E, WALWORTH
COUNTY, WISCONSIN.



SCALE - 1"=40'

LEGEND

- ⊗ - IRON PIPE FOUND
- * - IRON ROD FOUND
- () - RECORDED AS

I, DAVID F. ABELL, DO HEREBY CERTIFY
THAT I HAVE SURVEYED THE PROPERTY
HEREON DESCRIBED ACCORDING TO THE
OFFICIAL RECORDS AND THAT THE PLAT
HEREON IS A CORRECT REPRESENTATION
OF THE PROPERTY LINES TO THE BEST OF
MY KNOWLEDGE AND BELIEF.

David F. Abell
DAVID F. ABELL
WISCONSIN REGISTERED LAND SURVEYOR, S-1596

December 22, 1986
DATE JOB NUMBER - 86085

NOTE: THIS IS NOT A CERTIFIED COPY UNLESS SEALED.