


DUNHAM SURVEYING, S.C.
SURVEYING & SUBDIVIDING
DELAVAN, WISCONSIN 53115

(0.00) = recorded distance
• = 3/4" Iron Pipe Found
Owners: Leon & Mary Serruys
1415 South Shore Drive
Delavan, WI 53115

Scale - 1" = 40'

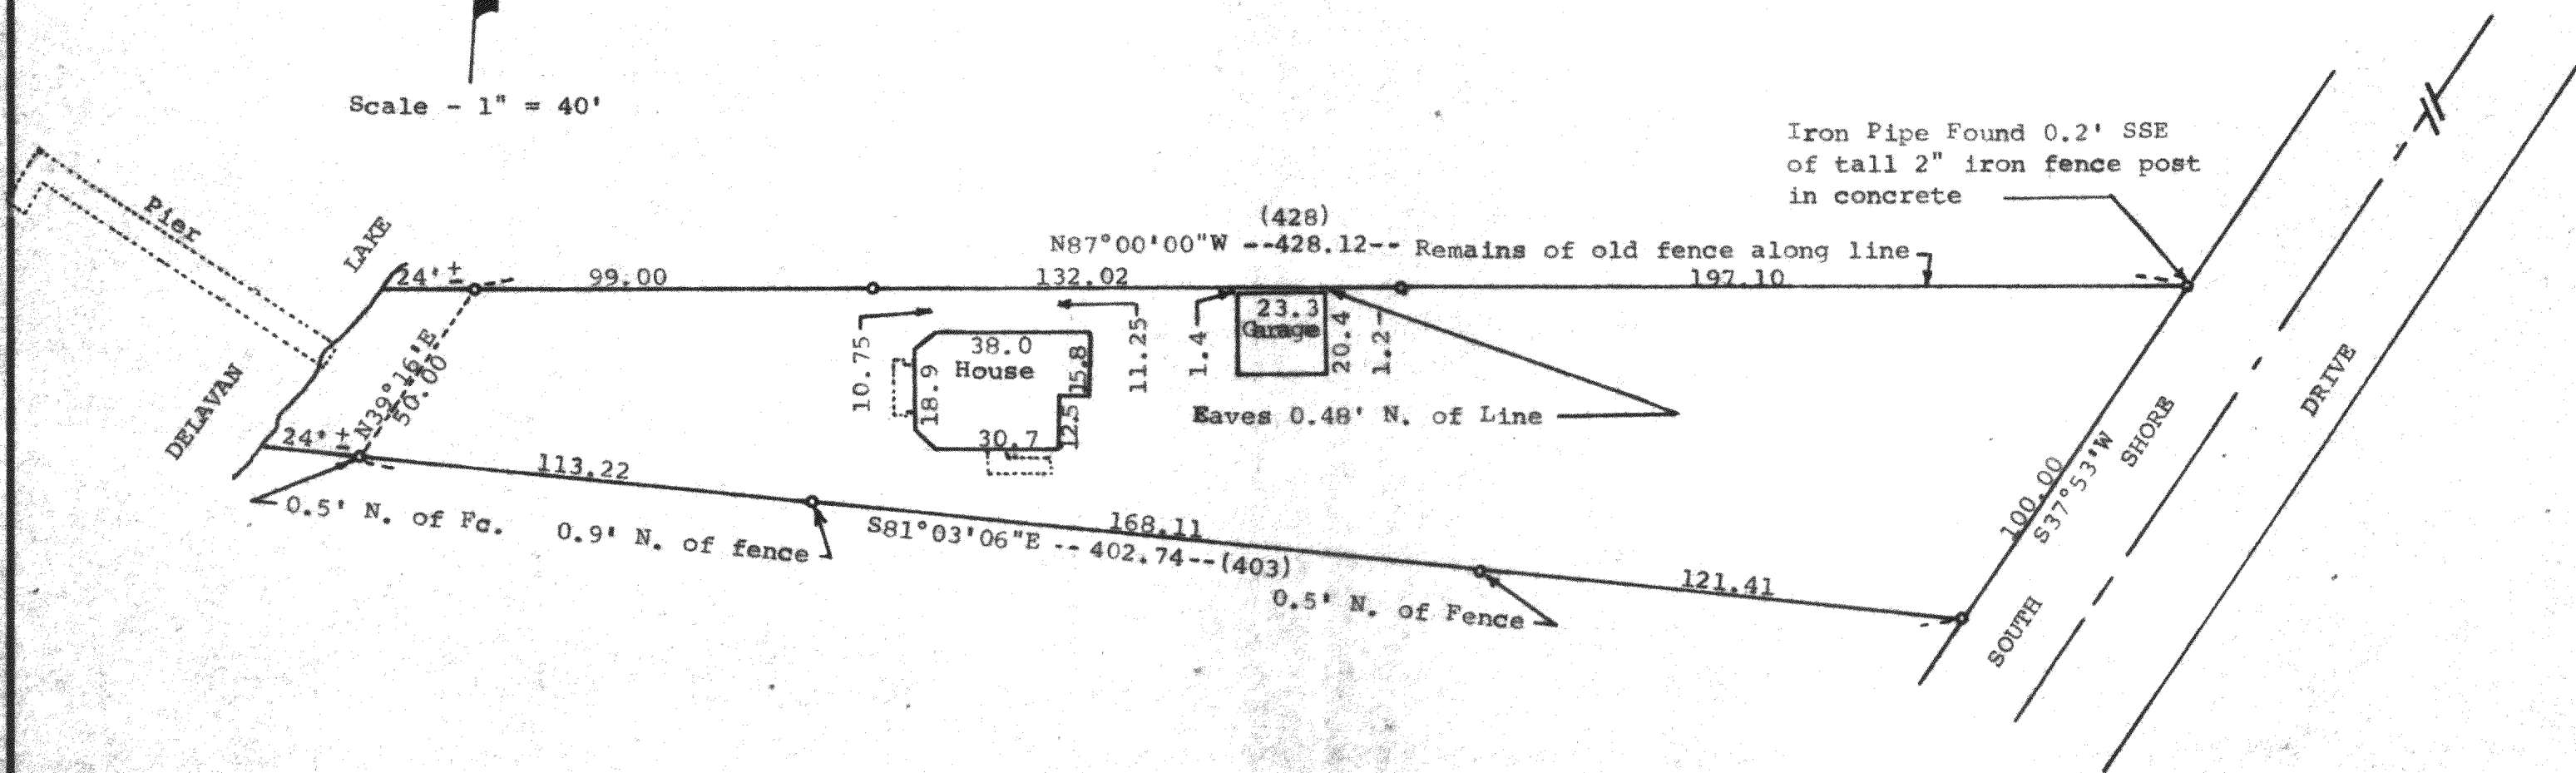

STATE OF WISCONSIN)
COUNTY OF WALWORTH)

I, George T. Dunham, Surveyor, certify that I have surveyed the property described as follows:

All that certain piece or parcel of land lying and being in the SE $\frac{1}{4}$ of Section 22, T 2 N, R 16 E, Being the Town of Delavan, described as follows: Beginning at an iron fence post on the NW'ly side of the road running across said quarter section near the Lake at the SE'ly corner of land conveyed to H. S. Meredith, the deed of which conveyance is on record in the office of the Register of Deeds in and for said County in Volume 163 of Deeds on page 427, and the said post being also 121.3 feet SW'ly of the brick gate post at the SE'ly corner of the land described in Vol. 161 of Deeds on page 468, in said Registrar's office; thence West along the South line of said Meredith's land 428 feet to a stake and continuing on the same line 30 feet more or less to shore of Delavan Lake; thence SW'ly along the said lake shore 50 feet more or less to a point; thence E'ly on a line 30 feet more or less to a stake that is 50 feet distant from the last mentioned stake and continuing on the same course and line 403 feet more to a stake on the NW'ly line of the said road 100 feet SW'ly of the place of beginning; thence NE'ly along the line of said road 100 feet to the place of beginning,

and that the map shown hereon is a correct representation thereof and shows the size and location of the property, its exterior boundaries, the location of all visible structures and dimensions of all principal buildings thereon, boundary fences, apparent easements, roadways and visible encroachments, if any, and that I have surveyed the property hereon described, according to the official records, to the best of my knowledge and belief.
July 27, 1987

George T. Dunham
George T. Dunham, Surveyor

