

ABELL

SURVEYING & MAPPING

DELAVAN, WISCONSIN 53115

414-728-6737

LAKE TRAIL
66' WIDE

PLAT OF SURVEY OF

LOT 28 OF THE FIRST ADDITION TO
LAKEWOOD ESTATES, T2N, R16E, W1/4W, WORTH
COUNTY, WISCONSIN.

ORDERED BY: CENTURY 21 SKANDIA

REALTY


312 S. 7th STREET

DELAVAN, WI 53115

29

28

27

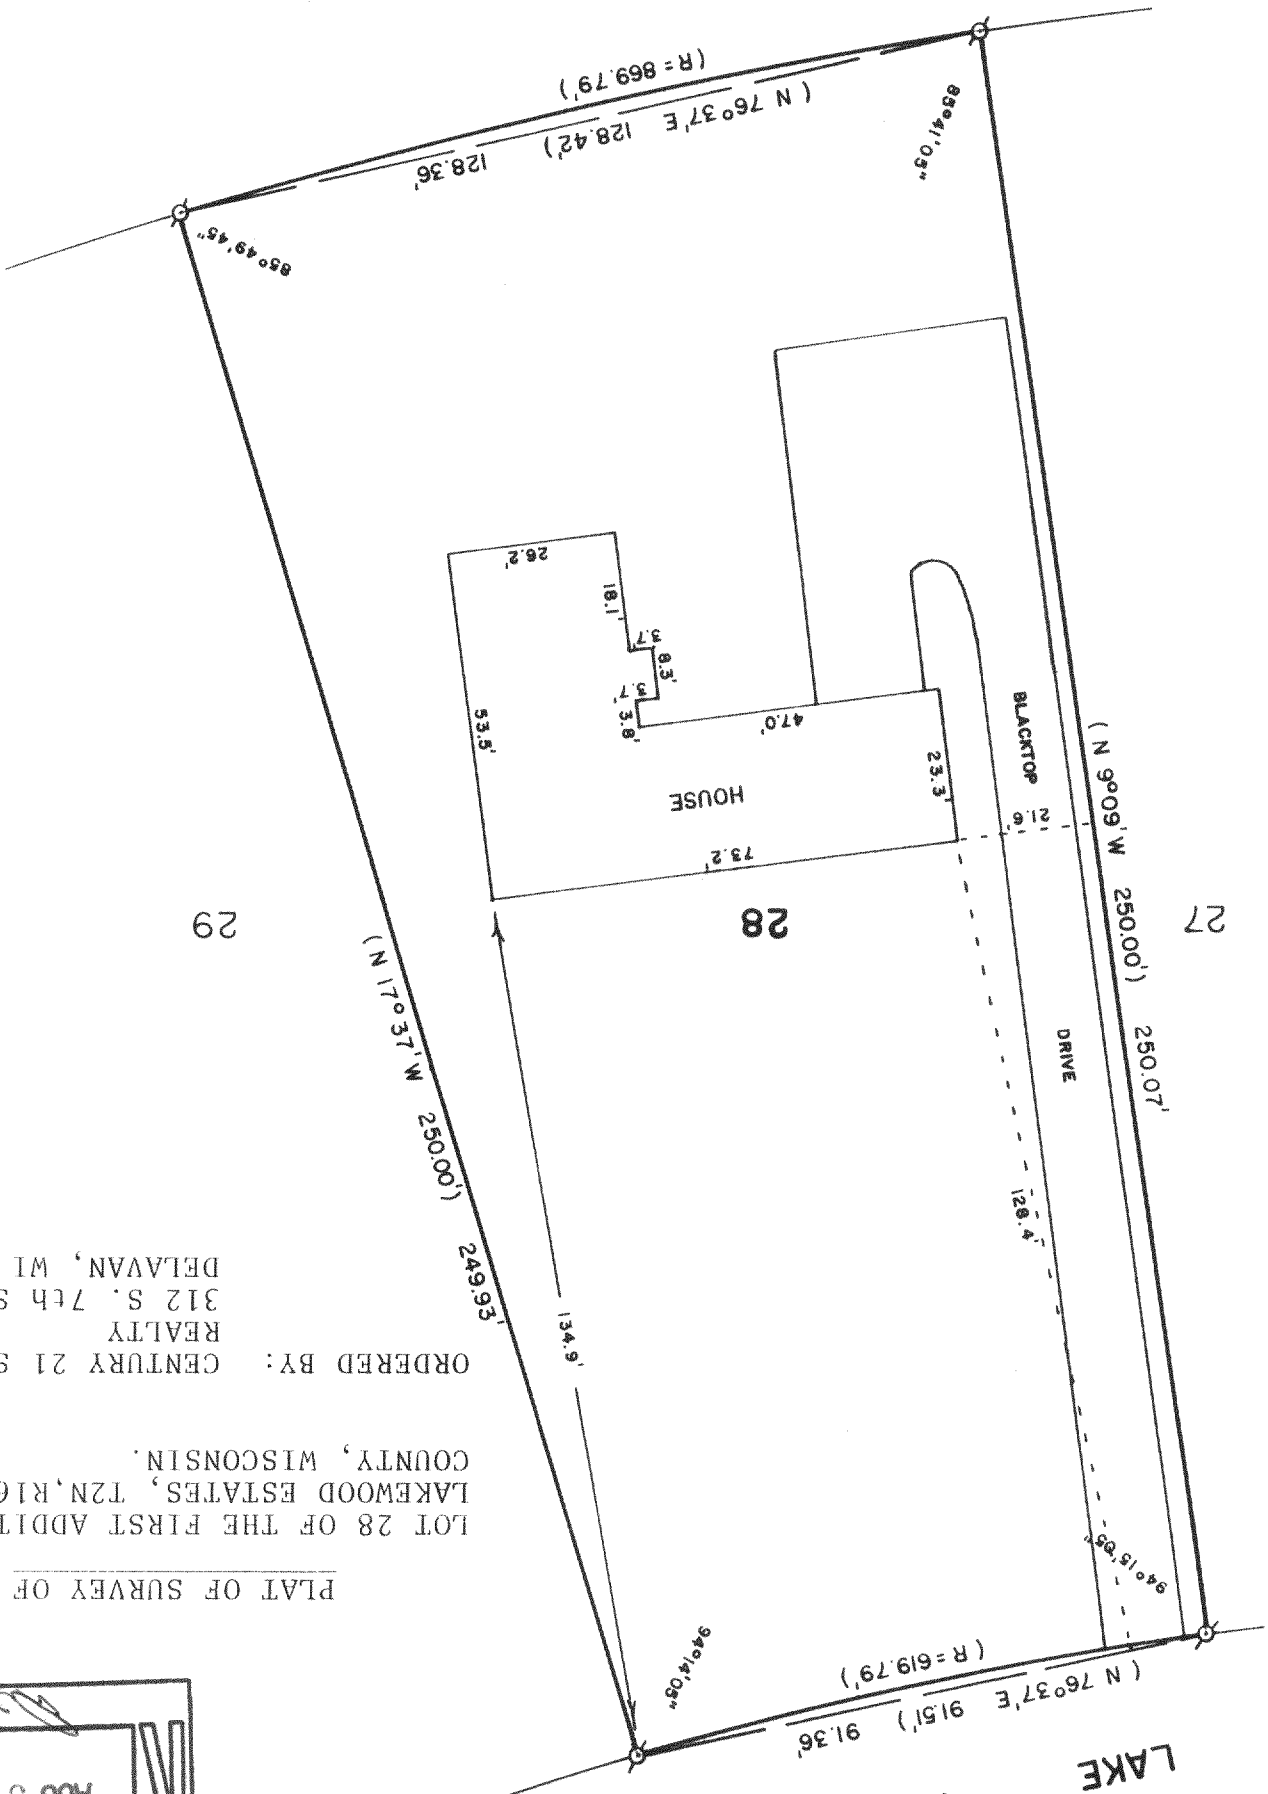

I, DAVID F. ABELL, DO HEREBY CERTIFY
THAT I HAVE SURVEYED THE PROPERTY
HEREON DESCRIBED ACCORDING TO THE
OFFICIAL RECORDS AND THAT THE PLAT
HEREON IS A CORRECT REPRESENTATION
OF THE PROPERTY LINES TO THE BEST OF
MY KNOWLEDGE AND BELIEF.

SCALE 1"=30'
LEGEND
○ - IRON PIPE FOUND
⊙ - RECORDED AS

David F. Abell
DAVID F. ABELL
WISCONSIN REGISTERED LAND SURVEYOR, S-1596

DATE August 17, 1987
JOB NUMBER - 87113

NOTE: THIS IS NOT A CERTIFIED COPY UNLESS SEALED.

7-13-A-8

