



**R.F. Sarko and Associates, Inc.**  
**Land Surveyors**  
**2919 University Avenue**  
**Madison, Wisconsin 53705**

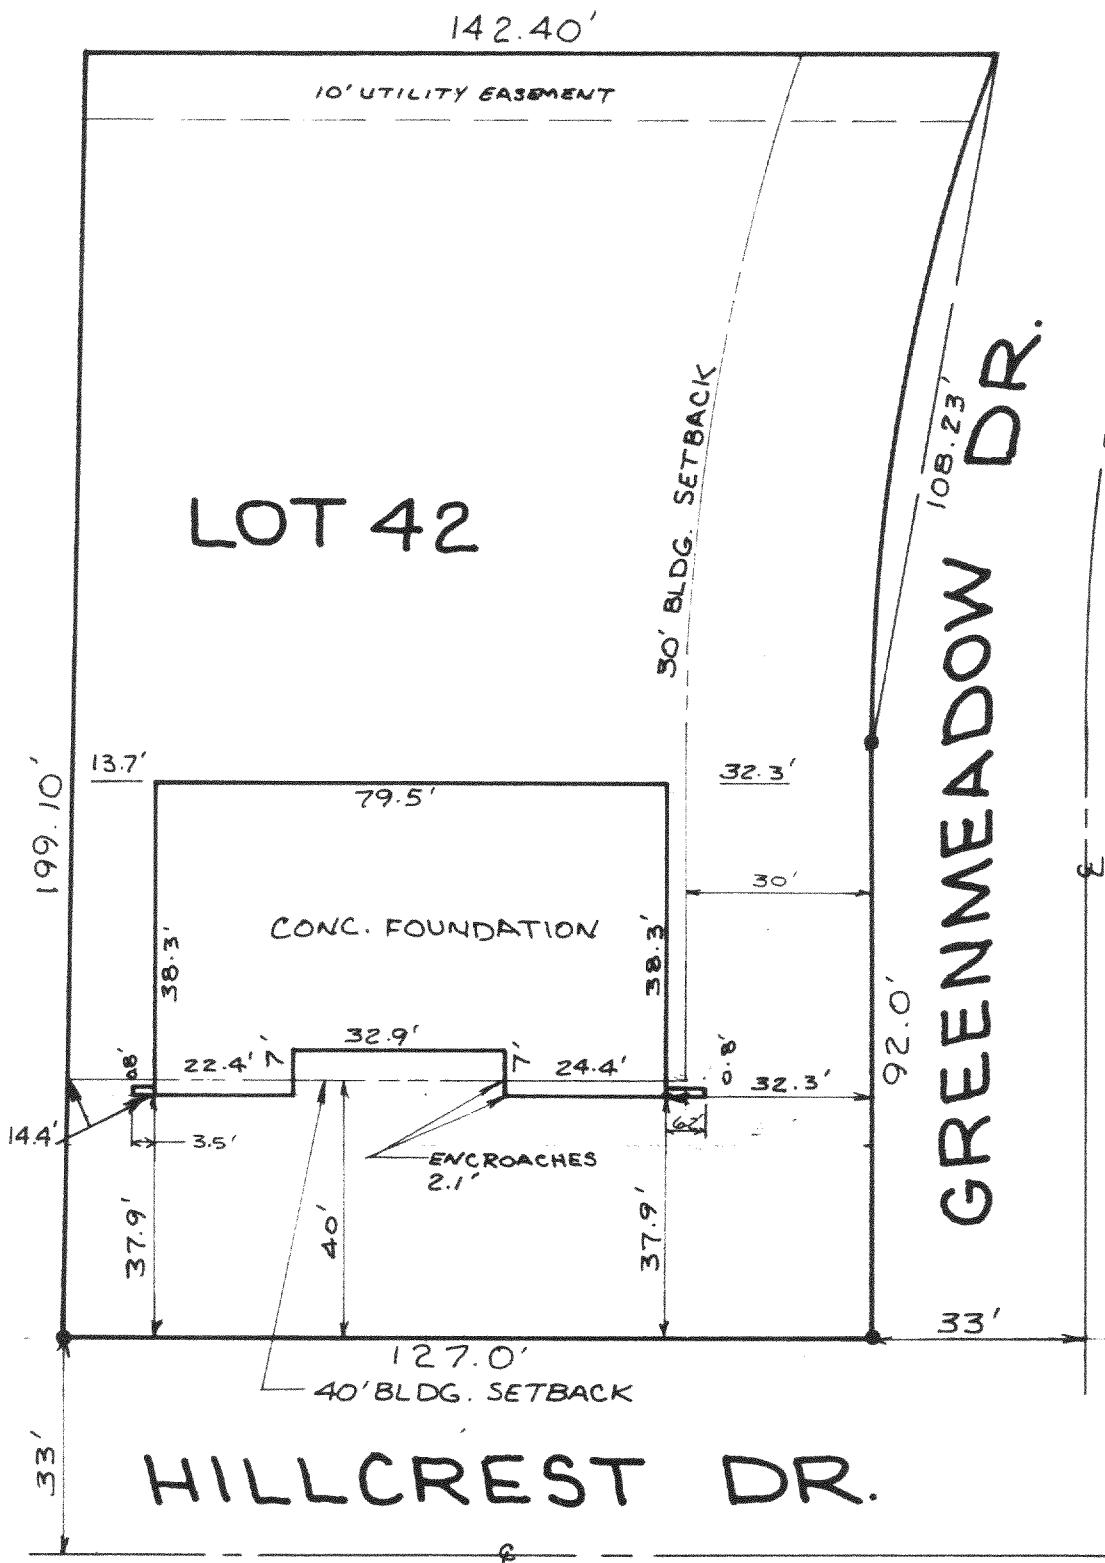

Mark Kupsch  
8-6-87

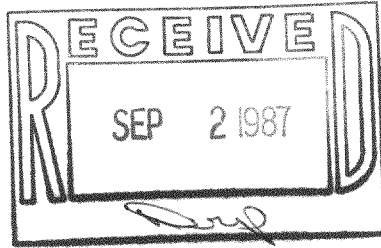

SCALE 1" = 30'

● FOUND IRON STAKE

Map Number: 4-20260  
Job Number: 17808  
Page One of Two

**MORTGAGE INSPECTION**

**R.F. Sarko and Associates, Inc.**  
Land Surveyors  
2919 University Avenue  
Madison, Wisconsin 53705

**LEGAL DESCRIPTION OF PROPERTY INSPECTED:**

Lot 42, Oak Meadow Subdivision, Town of Delavan, Walworth County,  
Wisconsin.

**ADDRESS OF PROPERTY INSPECTED:**

Hillcrest Drive  
Delavan, Wisconsin

**INSPECTED FOR:**

Mutual Savings and Loan Association  
2500 Milton Avenue  
Janesville, Wisconsin 53545

Attn: Doug Schnier


**CLIENT:**

Terry J. Yirek

**CERTIFICATE:**

"I, Mark Kupsch, Registered Land Surveyor in the State of Wisconsin, do hereby certify that I have inspected the above described property and that I have mapped the property according to the official records and that I have mapped the locations of all visible structures, the dimensions of all principal buildings, roadways, apparent easements and visible encroachments, if any. This mortgage inspection has been prepared in accordance with the requirements of the Mutual Savings and Loan Association and under an agreement between R.F. Sarko and Associates, Inc. and the Mutual Savings and Loan Association which excludes this mortgage inspection from all of the requirements of Section AE 7, per Section AE 7.01(2), Wisconsin Administrative Code, and therefore, this mortgage inspection may not comply with all of the requirements of Section AE 7. This mortgage inspection is made for the exclusive use of the present owners of the property and also those who purchase, mortgage or guarantee the title thereto within one year from date hereof and as to them we certify the accuracy of said mortgage inspection as shown."

Dated this 6th day of August, 1987.

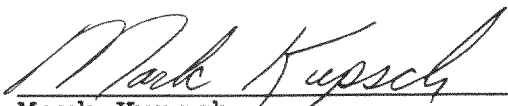  
Mark Kupsch  
Wisconsin Registered Land Surveyor  
Number S-1426



Map Number: 4-20260  
Job Number: 17808  
Page Two of Two