


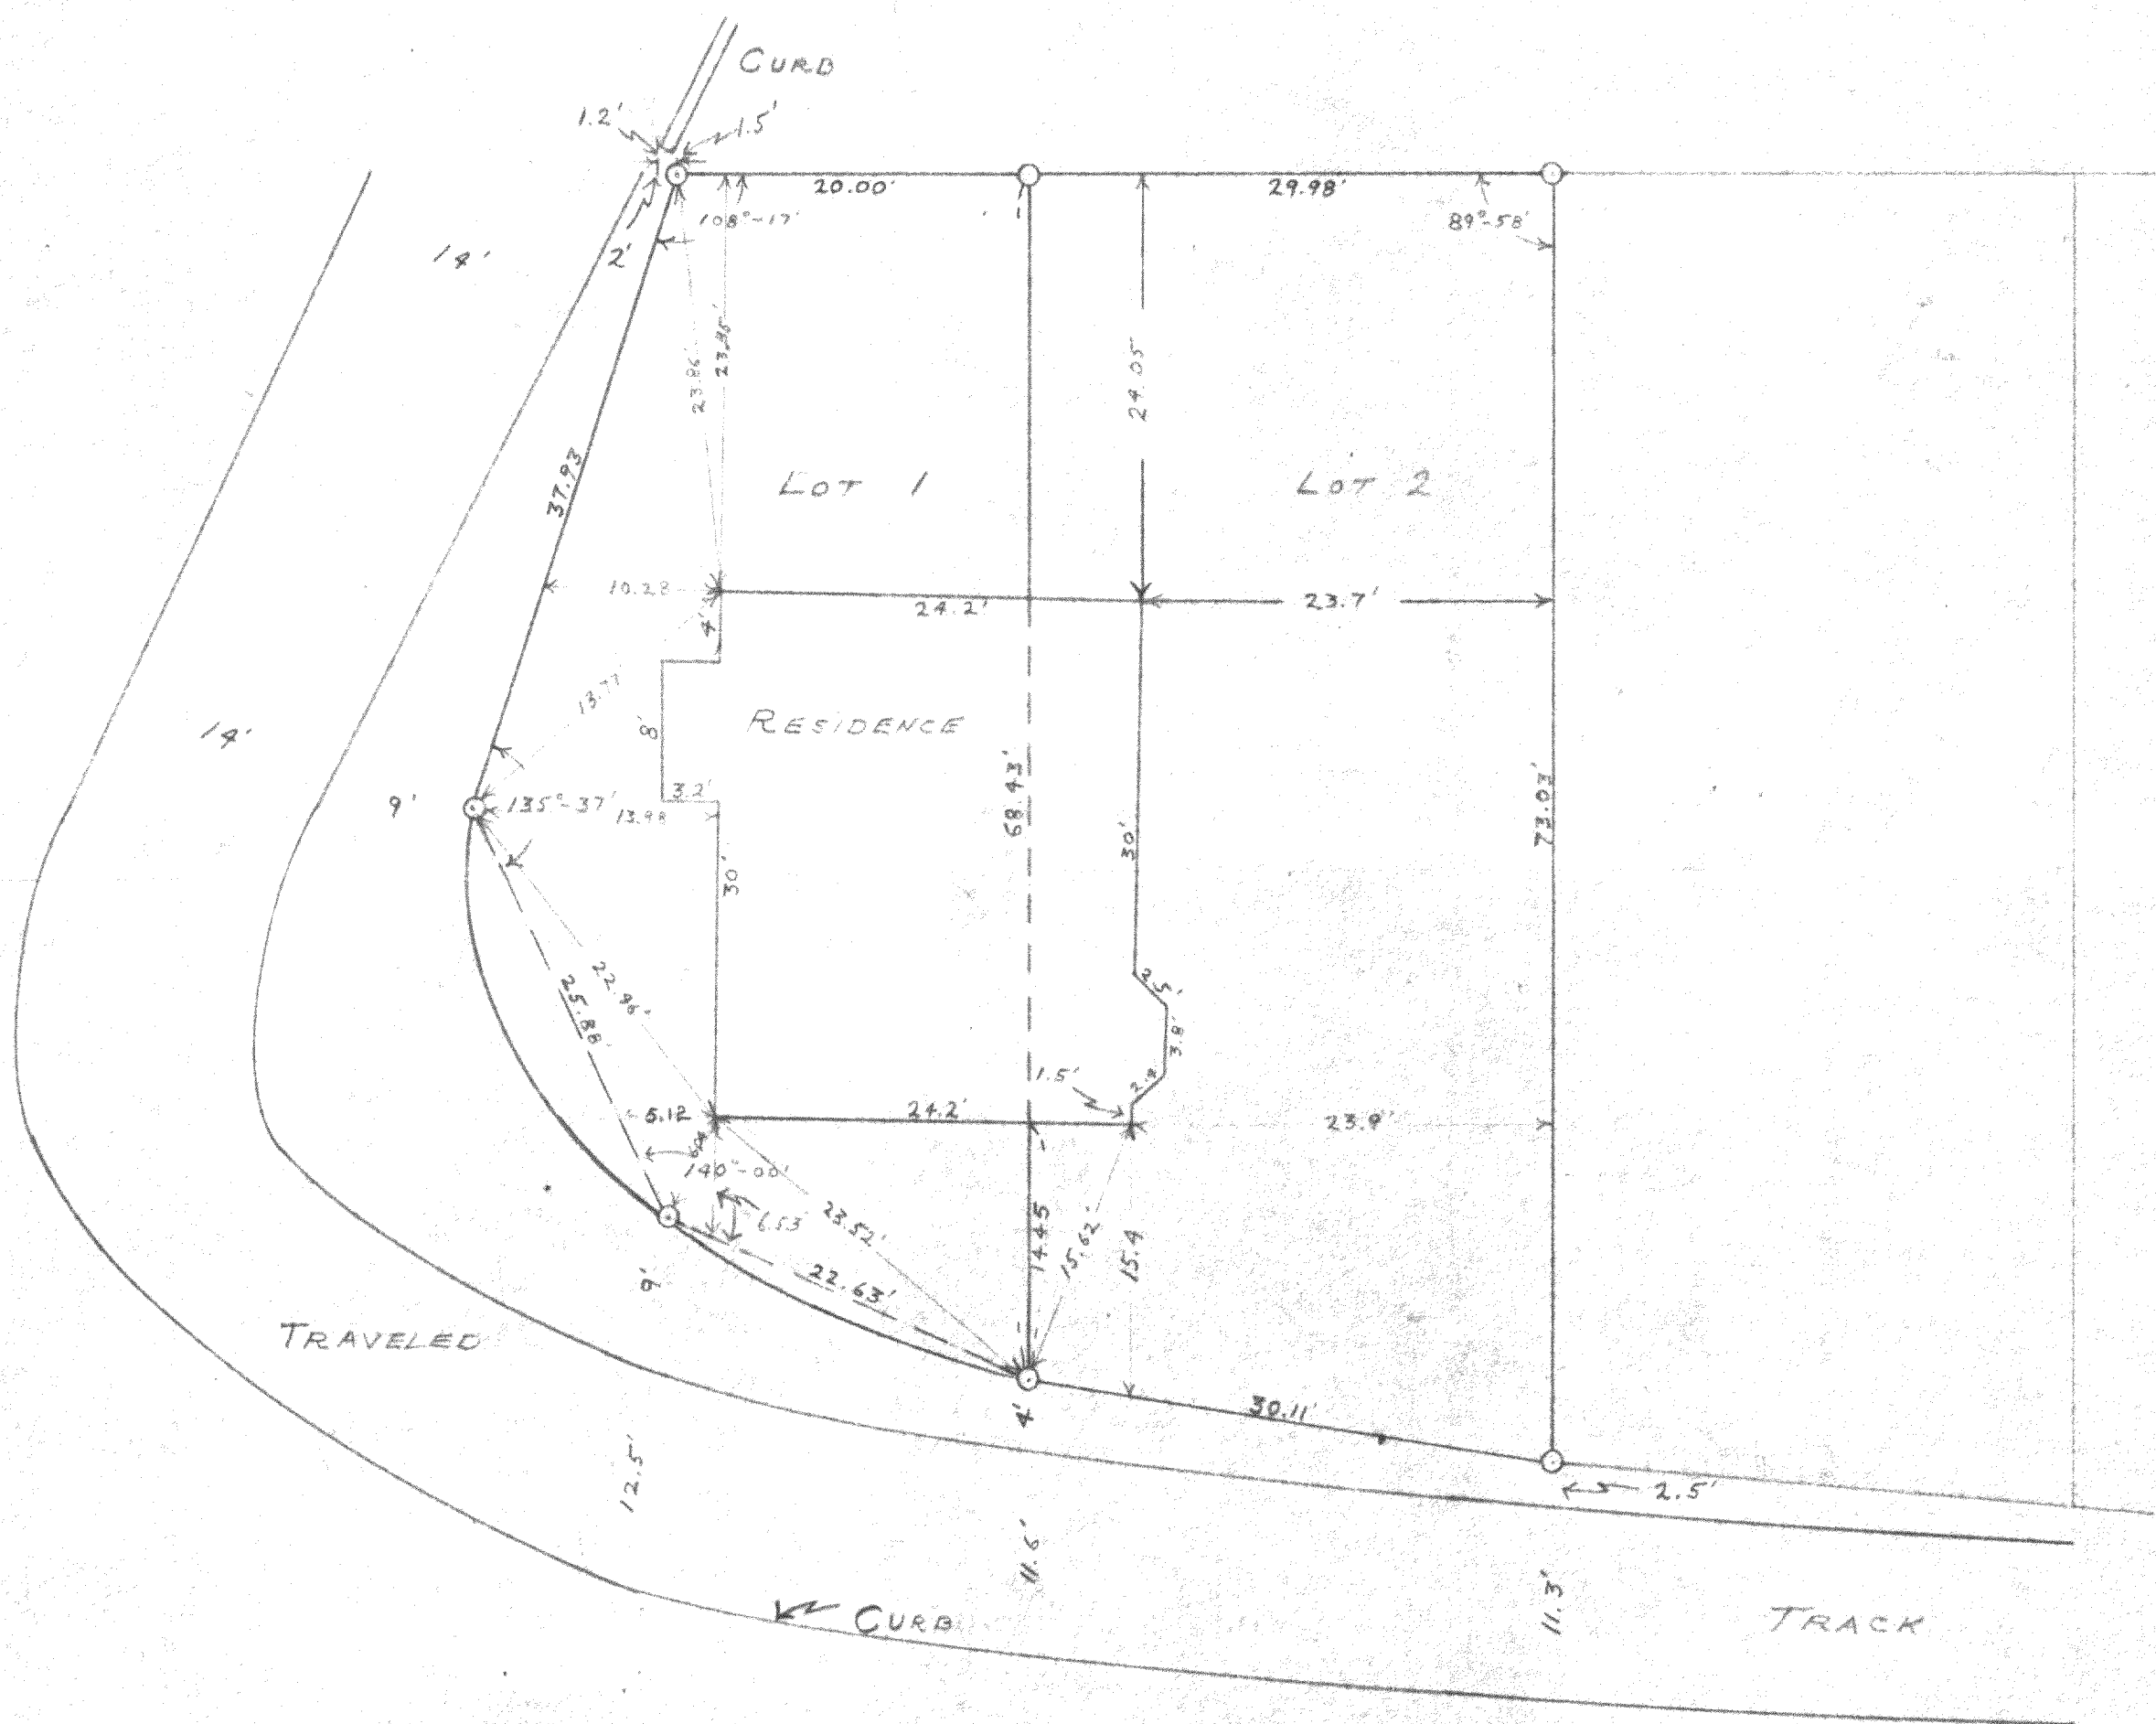

PLAT OF SURVEY OF LOTS 1 AND  
2 BLOCK Y OF DELAVAN LAKE  
ASSEMBLY GROUNDS, WALWORTH COUNTY,  
WISCONSIN.  
AUGUST 1, 1951

*Lloyd L. Jensen*  
WALWORTH COUNTY SURVEYOR