


DUNHAM SURVEYING, S.C.
SURVEYING & SUBDIVIDING
DELAVAN, WISCONSIN 53115

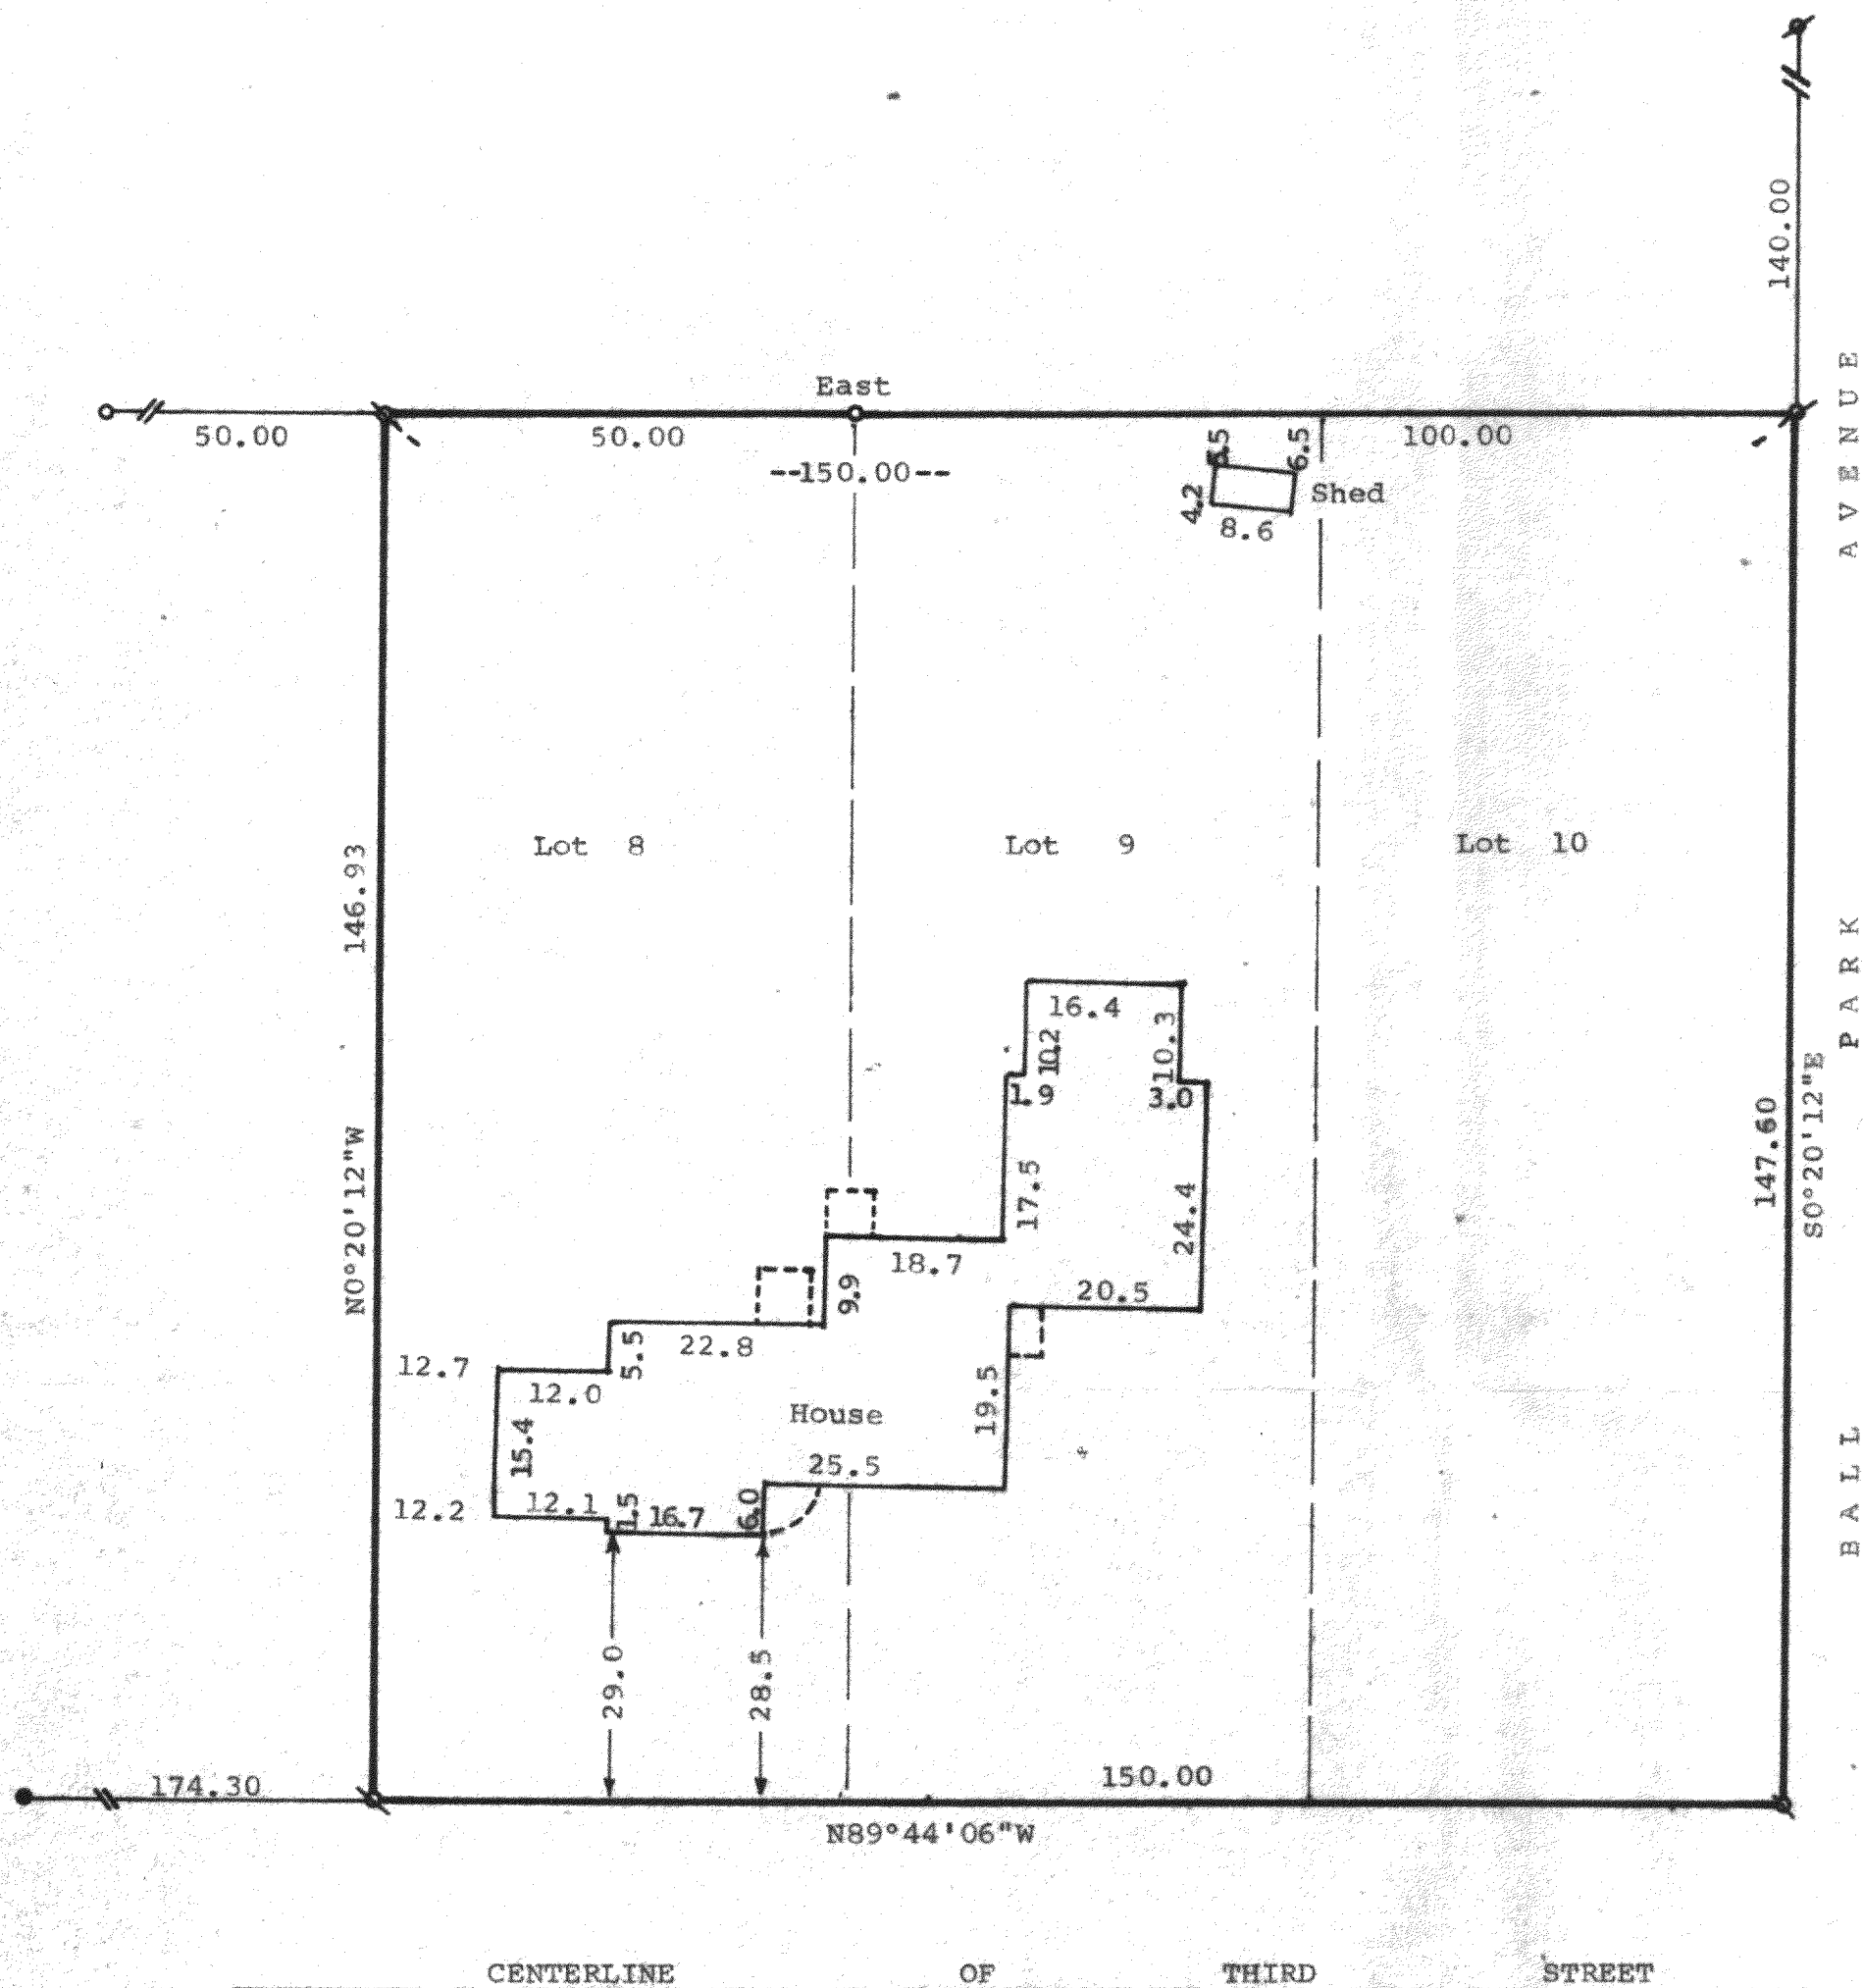

Scale - 1" = 20'
 ⌀ = 1 1/4" Dia. Iron Pipe Found
 ▧ = 1 1/4"x24" Iron Pipe Set
 ● = 1/2" Dia. Iron Pipe Found
 ○ = Iron Pipe Found, Size not noted.

Ordered By: Century 21
 Skandia Realty,
 312 S. 7th Street
 Delavan, WI 53115
 Bearings are based on the north
 line of the property, assumed
 bearing of East.

STATE OF WISCONSIN)
 COUNTY OF WALWORTH) ss

I, George T. Dunham, Surveyor, certify that I have surveyed the property described as follows,

Lots 8, 9, 10 of Block 4 of Inlet Oaks Subdivision Number 3, a subdivision located in the Southeast Fractional 1/4 of Section 15, T2N, R16E, Walworth County, Wisconsin,

and that the map shown hereon is a correct representation thereof and shows the size and location of the property, its exterior boundaries, the location of all visible structures and dimensions of all principal buildings thereon, boundary fences, apparent easements, roadways and visible encroachments, if any, and that I have surveyed the property hereon described according to the official records, to the best of my knowledge and belief.

October 7, 1987.

George T. Dunham
 George T. Dunham, Surveyor

