

**ABELL
SURVEYING & MAPPING**

DELAVAN, WISCONSIN 53115

414-728-6737

PARK



SCALE 1"=10'

LEGEND


- ⊙ - IRON PIPE FOUND
- - IRON PIPE SET
- ⊕ - MANHOLE COVER
- () - RECORDED AS

CENTRAL LINE

PARK

DELAVAN


LAKE

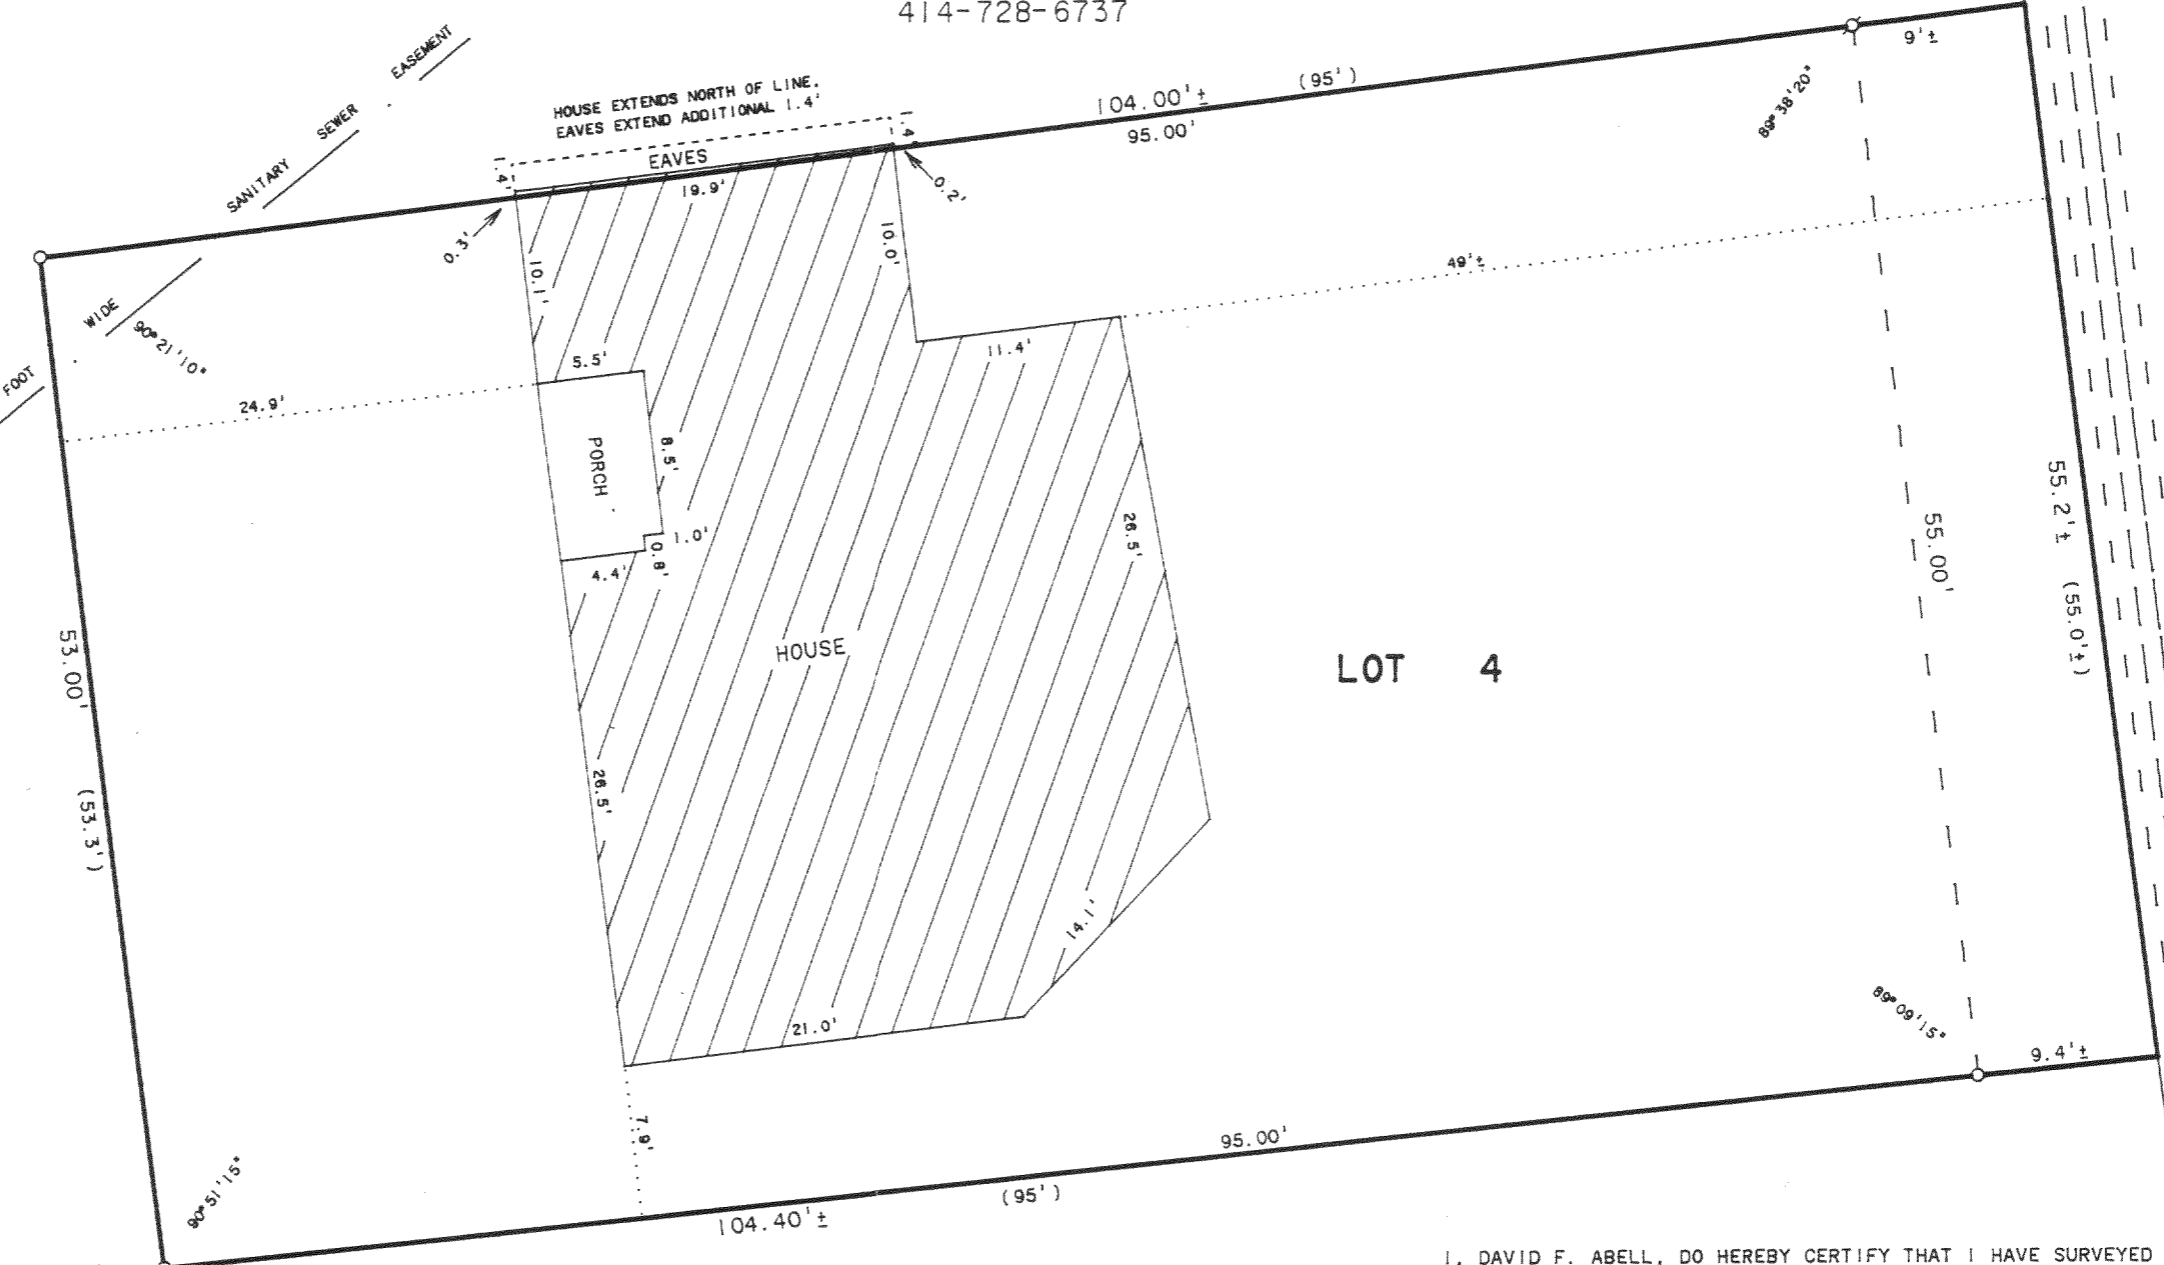

LOT 4

LOT 5

ORDERED BY: BOB HAM
3 RUSSELL CIRCLE
NATICK, MA. 01760

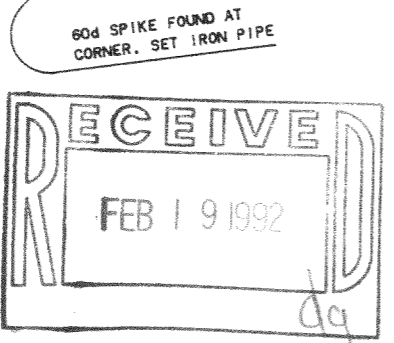

PLAT OF SURVEY OF

LOT 4 OF THE ADDITION TO WILLOW POINT PARK,
LOCATED IN T2N, R16E, WALWORTH COUNTY, WISCONSIN.

I, DAVID F. ABELL, DO HEREBY CERTIFY THAT I HAVE SURVEYED THE PROPERTY HEREON DESCRIBED ACCORDING TO THE OFFICAL RECORDS AND THAT THE PLAT HEREON IS A CORRECT REPRESENTATION OF THE PROPERTY LINES TO THE BEST OF MY KNOWLEDGE AND BELIEF.

David F. Abell

DAVID F. ABELL
WISCONSIN REGISTERED LAND SURVEYOR, S-1596

December 27, 1991

DATE JOB NUMBER - 91192

NOTE: THIS IS NOT A CERTIFIED COPY UNLESS SEALED.