
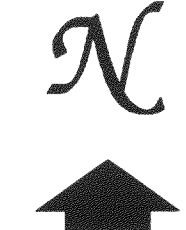


ABELL  
SURVEYING & MAPPING

1140 SEQUOIA STREET • DELAVAN, WISCONSIN 53115  
262-728-6737

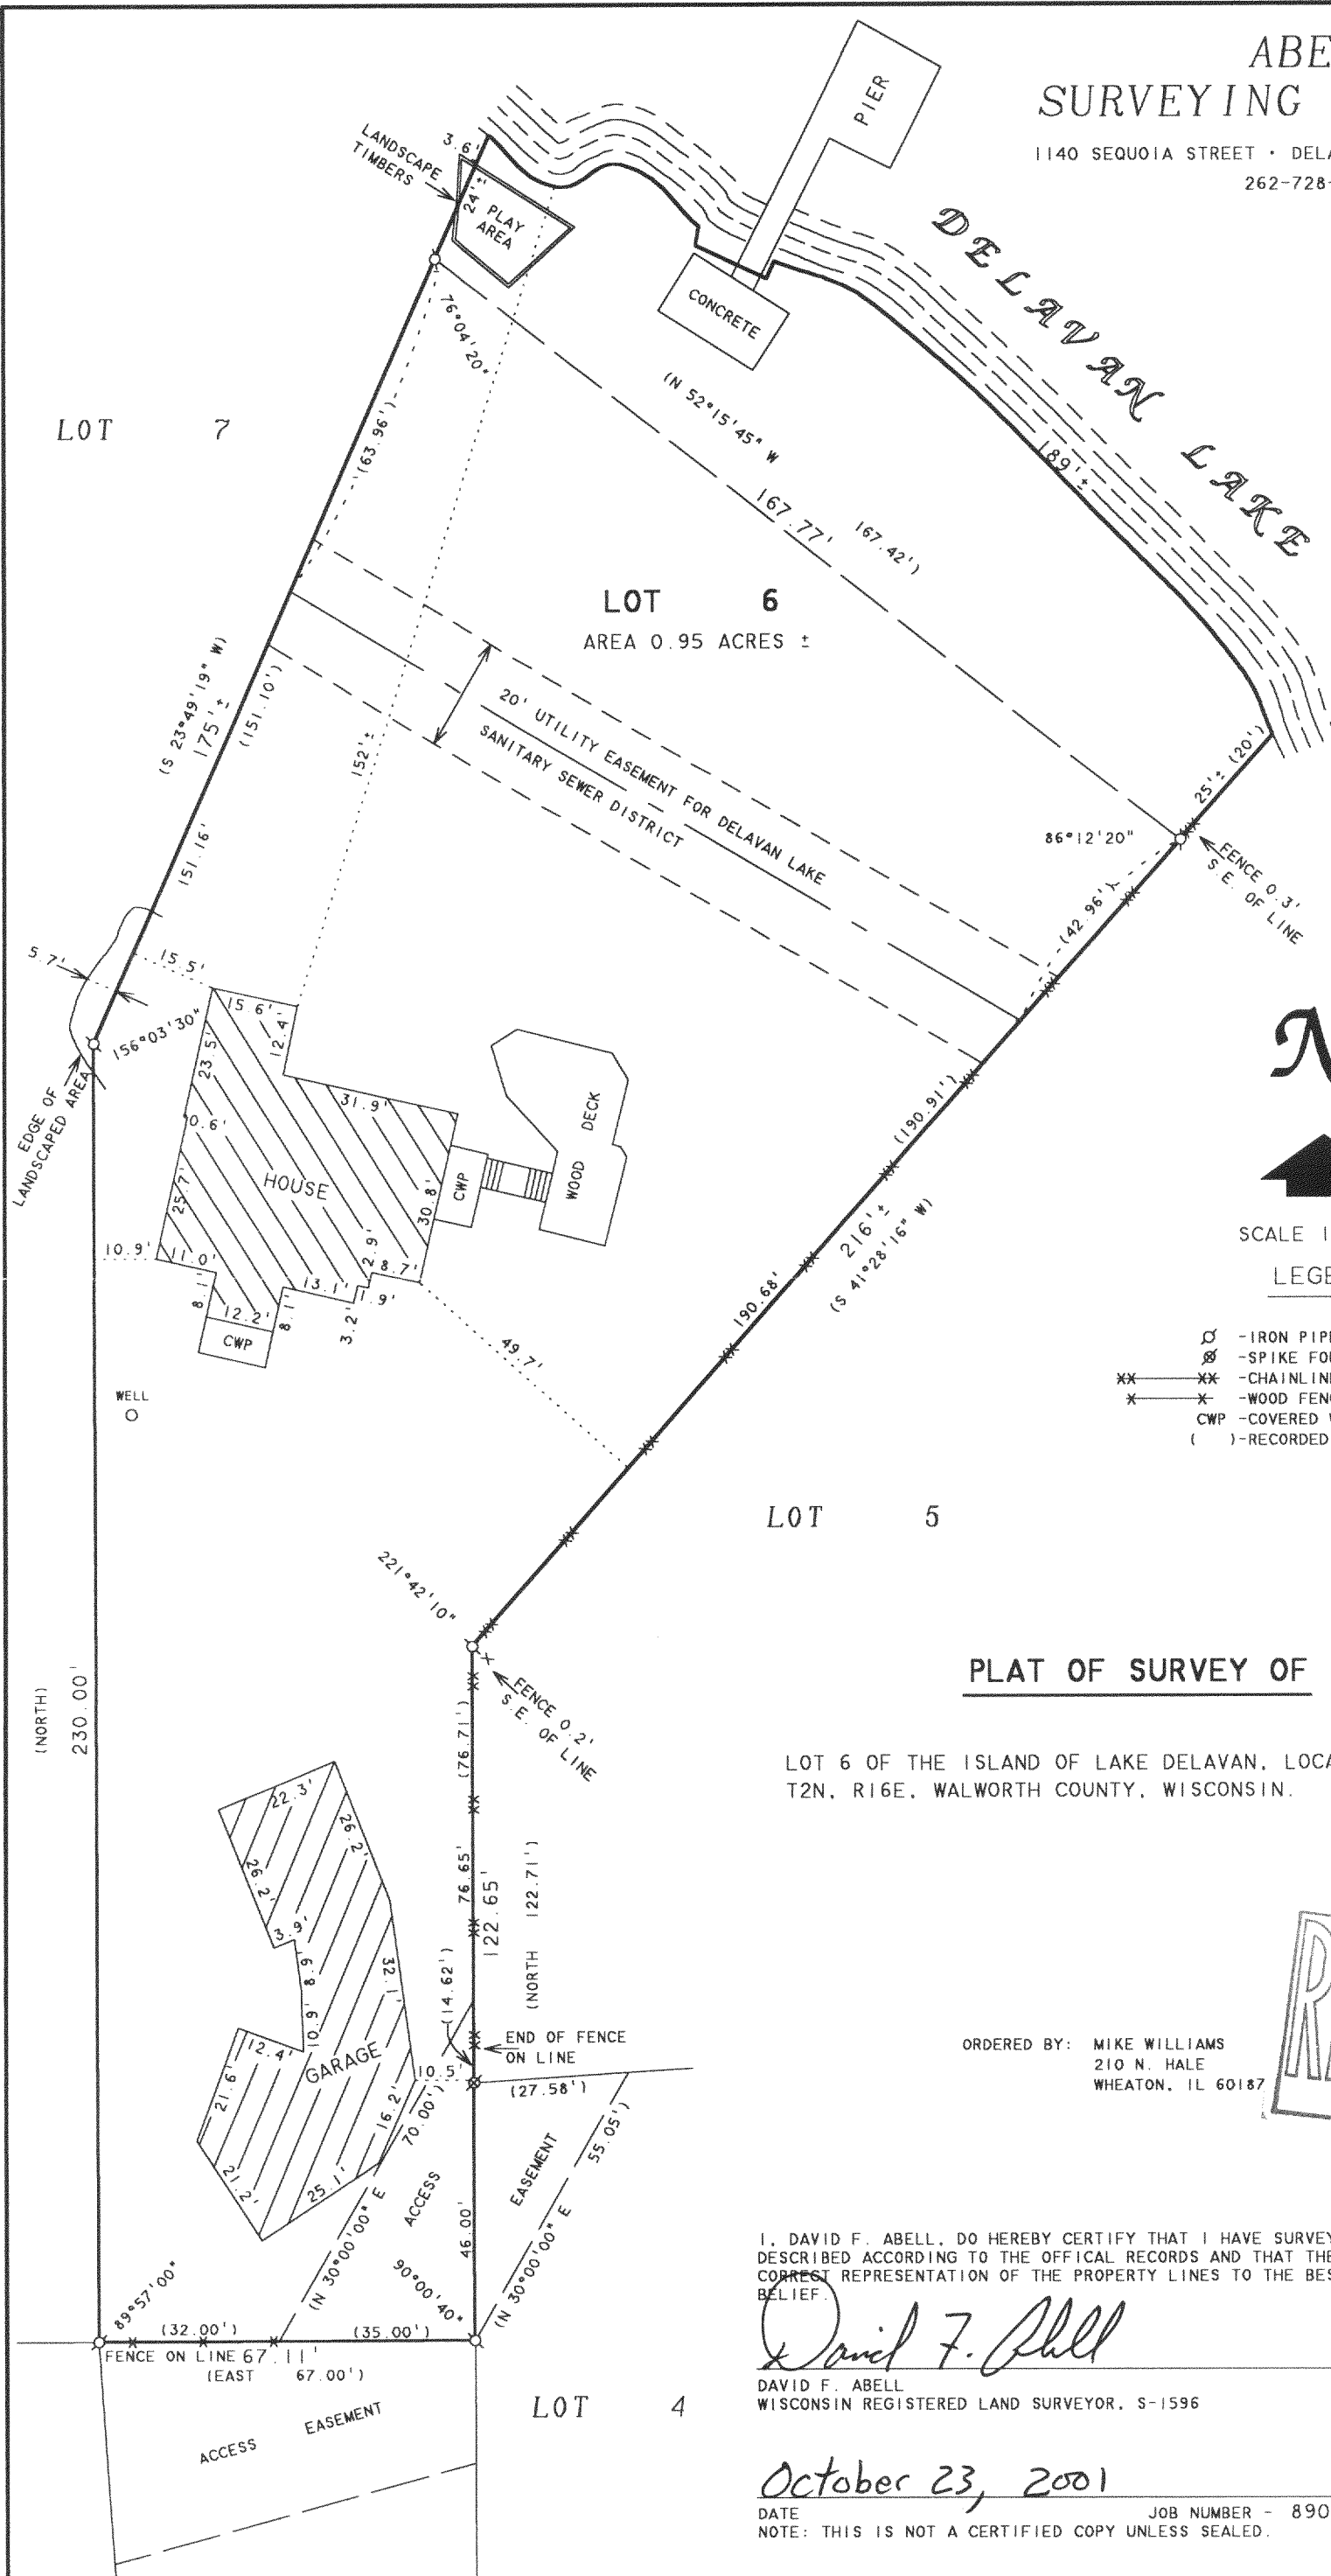

SCALE 1" = 30'


LEGEND

- ⊙ - IRON PIPE FOUND
- ⊗ - SPIKE FOUND
- XX - CHAINLINK FENCE
- \* - WOOD FENCE
- CWP - COVERED WOOD PORCH
- ( ) - RECORDED AS

PLAT OF SURVEY OF

LOT 6 OF THE ISLAND OF LAKE DELAVAN, LOCATED IN  
T2N, R16E, WALWORTH COUNTY, WISCONSIN.

ORDERED BY: MIKE WILLIAMS  
210 N. HALE  
WHEATON, IL 60187

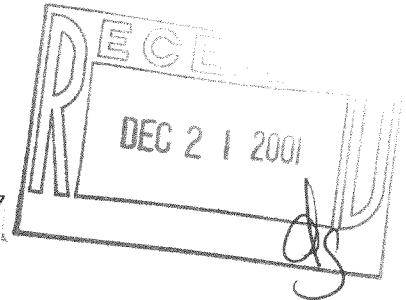

I, DAVID F. ABELL, DO HEREBY CERTIFY THAT I HAVE SURVEYED THE PROPERTY HEREON DESCRIBED ACCORDING TO THE OFFICAL RECORDS AND THAT THE PLAT HEREON IS A CORRECT REPRESENTATION OF THE PROPERTY LINES TO THE BEST OF MY KNOWLEDGE AND BELIEF

*David F. Abell*

DAVID F. ABELL  
WISCONSIN REGISTERED LAND SURVEYOR, S-1596

October 23, 2001

DATE: October 23, 2001 JOB NUMBER - 89099A  
NOTE: THIS IS NOT A CERTIFIED COPY UNLESS SEALED.

FIS-6

216-3118