


PREPARED FOR:
 HOMESTEAD REALTY
 520 BROAD STREET
 LAKE GENEVA, WI
 53147

PLAT OF SURVEY

- OF -


J.K. SURVEYING INC.
 N3705 WILLOWBEND LANE
 LAKE GENEVA, WI, 53147
 262-248-3697

LOT 9 OF POINT COMFORT ALSO PART OF PARK
 LYING BETWEEN PLAT AND LAKE ROAD AND THAT PART
 OF PARK LYING BETWEEN PLAT AND LAKE BY EXTENDING
 NORTH AND SOUTH LINES
 LOCATED IN SECTION 22, TOWN 2 NORTH, RANGE 16 EAST,
 WALWORTH COUNTY, WISCONSIN

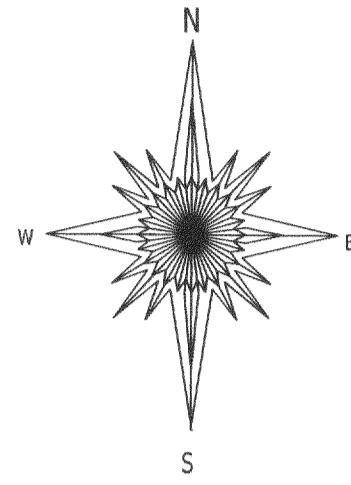

SCALE 1" = 20'

NOTE: BEARINGS REFERENCED TO PREVIOUS SURVEY OF RECORD

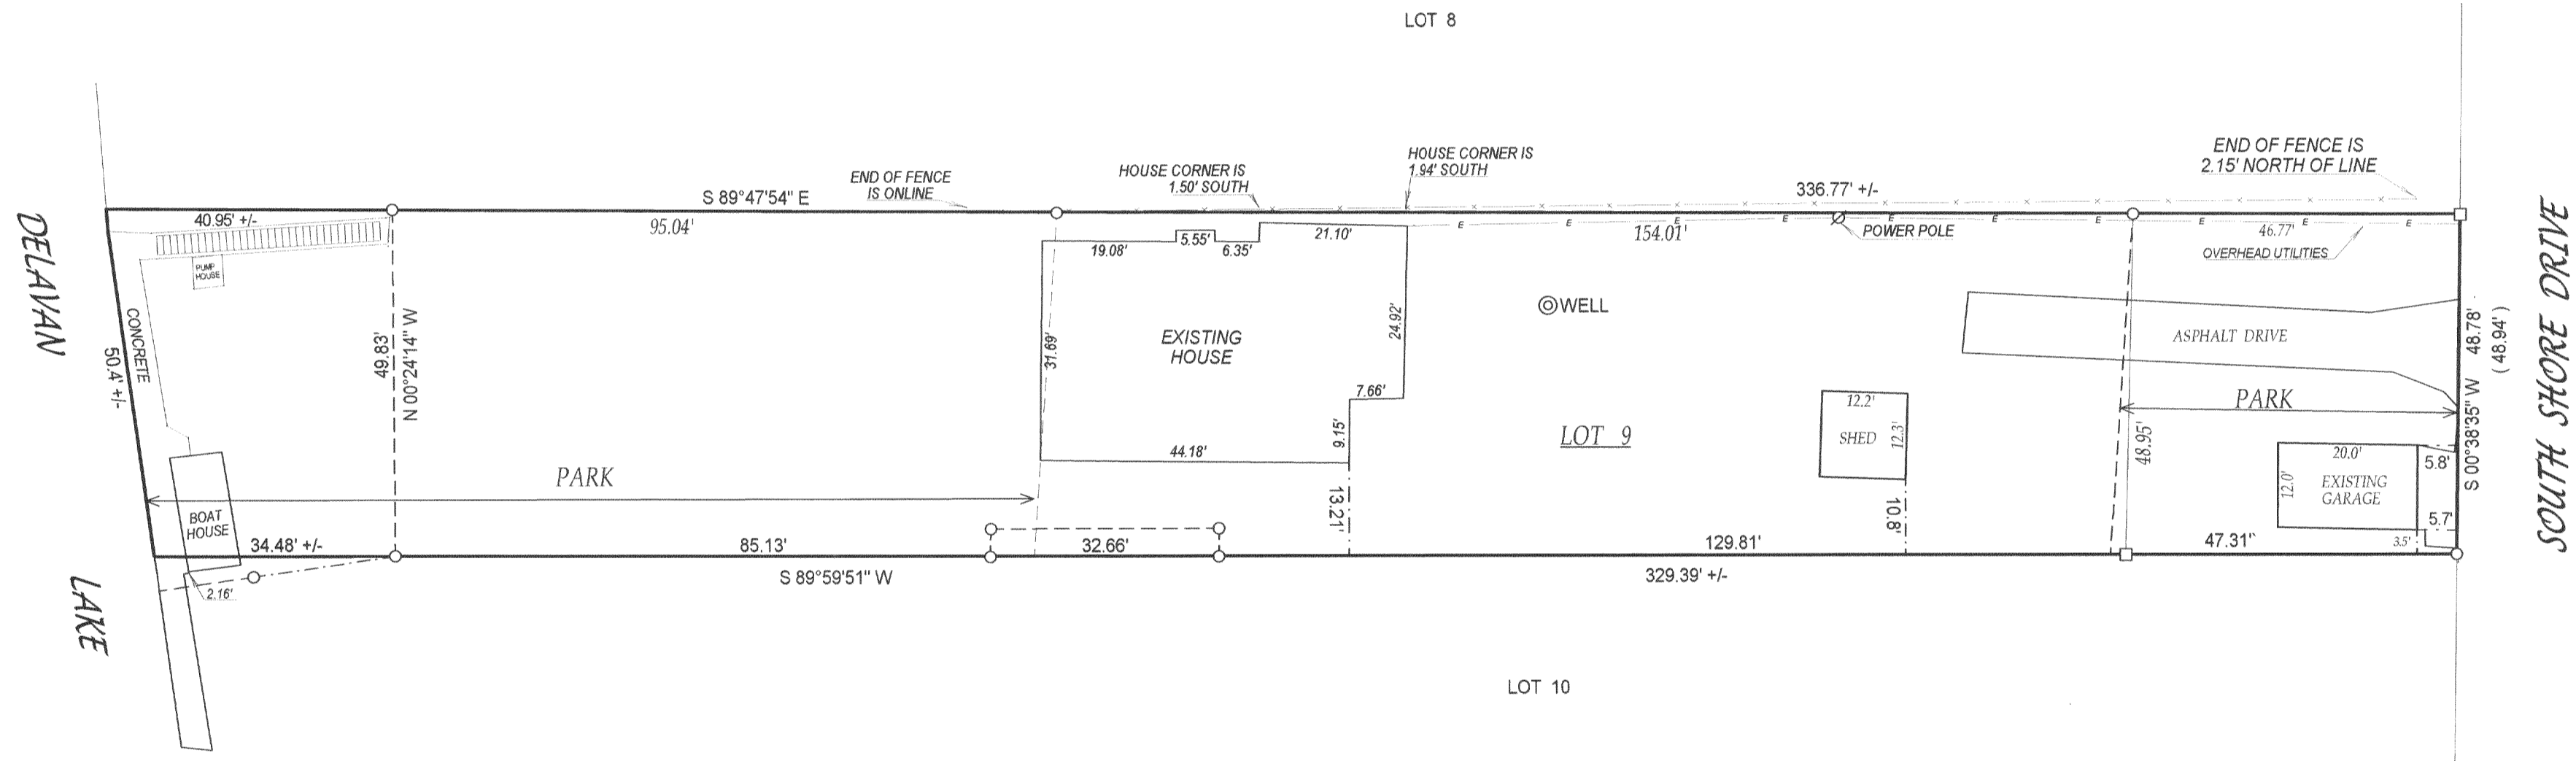

- () = recorded as
- = found iron bar
- = found iron pipe
- = set iron pipe
- = set iron bar

SCALE 1" = 20'

JOB # 03-513

TAX ID # FPC00006

OCT - 3 2003

JPK

COMPARE LEGAL DESCRIPTION ABOVE AND DRAWING WITH DEED. FOR BUILDING RESTRICTIONS AND EASEMENTS NOT SHOWN, REFER TO DEED, ABSTRACT SOURCES AND LOCAL MUNICIPAL CODES. NOTIFY THE SURVEYOR IMMEDIATELY OF ANY DISCREPANCY.

"I hereby certify that I have surveyed the above described property and that the above map is a true representation thereof and shows the size and location of all visible structures, apparent easements and encroachments if any."

This survey is made for the present owners of the property, and those who purchase, mortgage, or guarantee the title thereto, within one year from the date hereof.

DATED THIS 26th DAY OF AUGUST, 2003



John P. Krott
 JOHN KROTT S - 2258
 Wisconsin Registered Land Surveyor
 (original if signed in red)

216-3630