

Plat of Survey



of

Lot 28 of the First Addition to Lakewood Estates,

a subdivision located in the Southwest 1/4 of Section 21, Town 2 North, Range 16 East, Town of Delavan, Walworth County, Wisconsin.

Lake Trail (66' Wide)

Surveyed for: **Hibl's Real Estate Sales, Inc.**
1034 B Ann Street
Delavan, Wisconsin. 53115

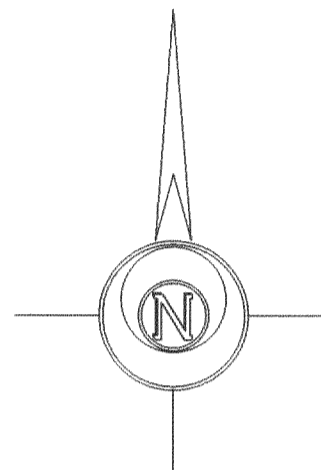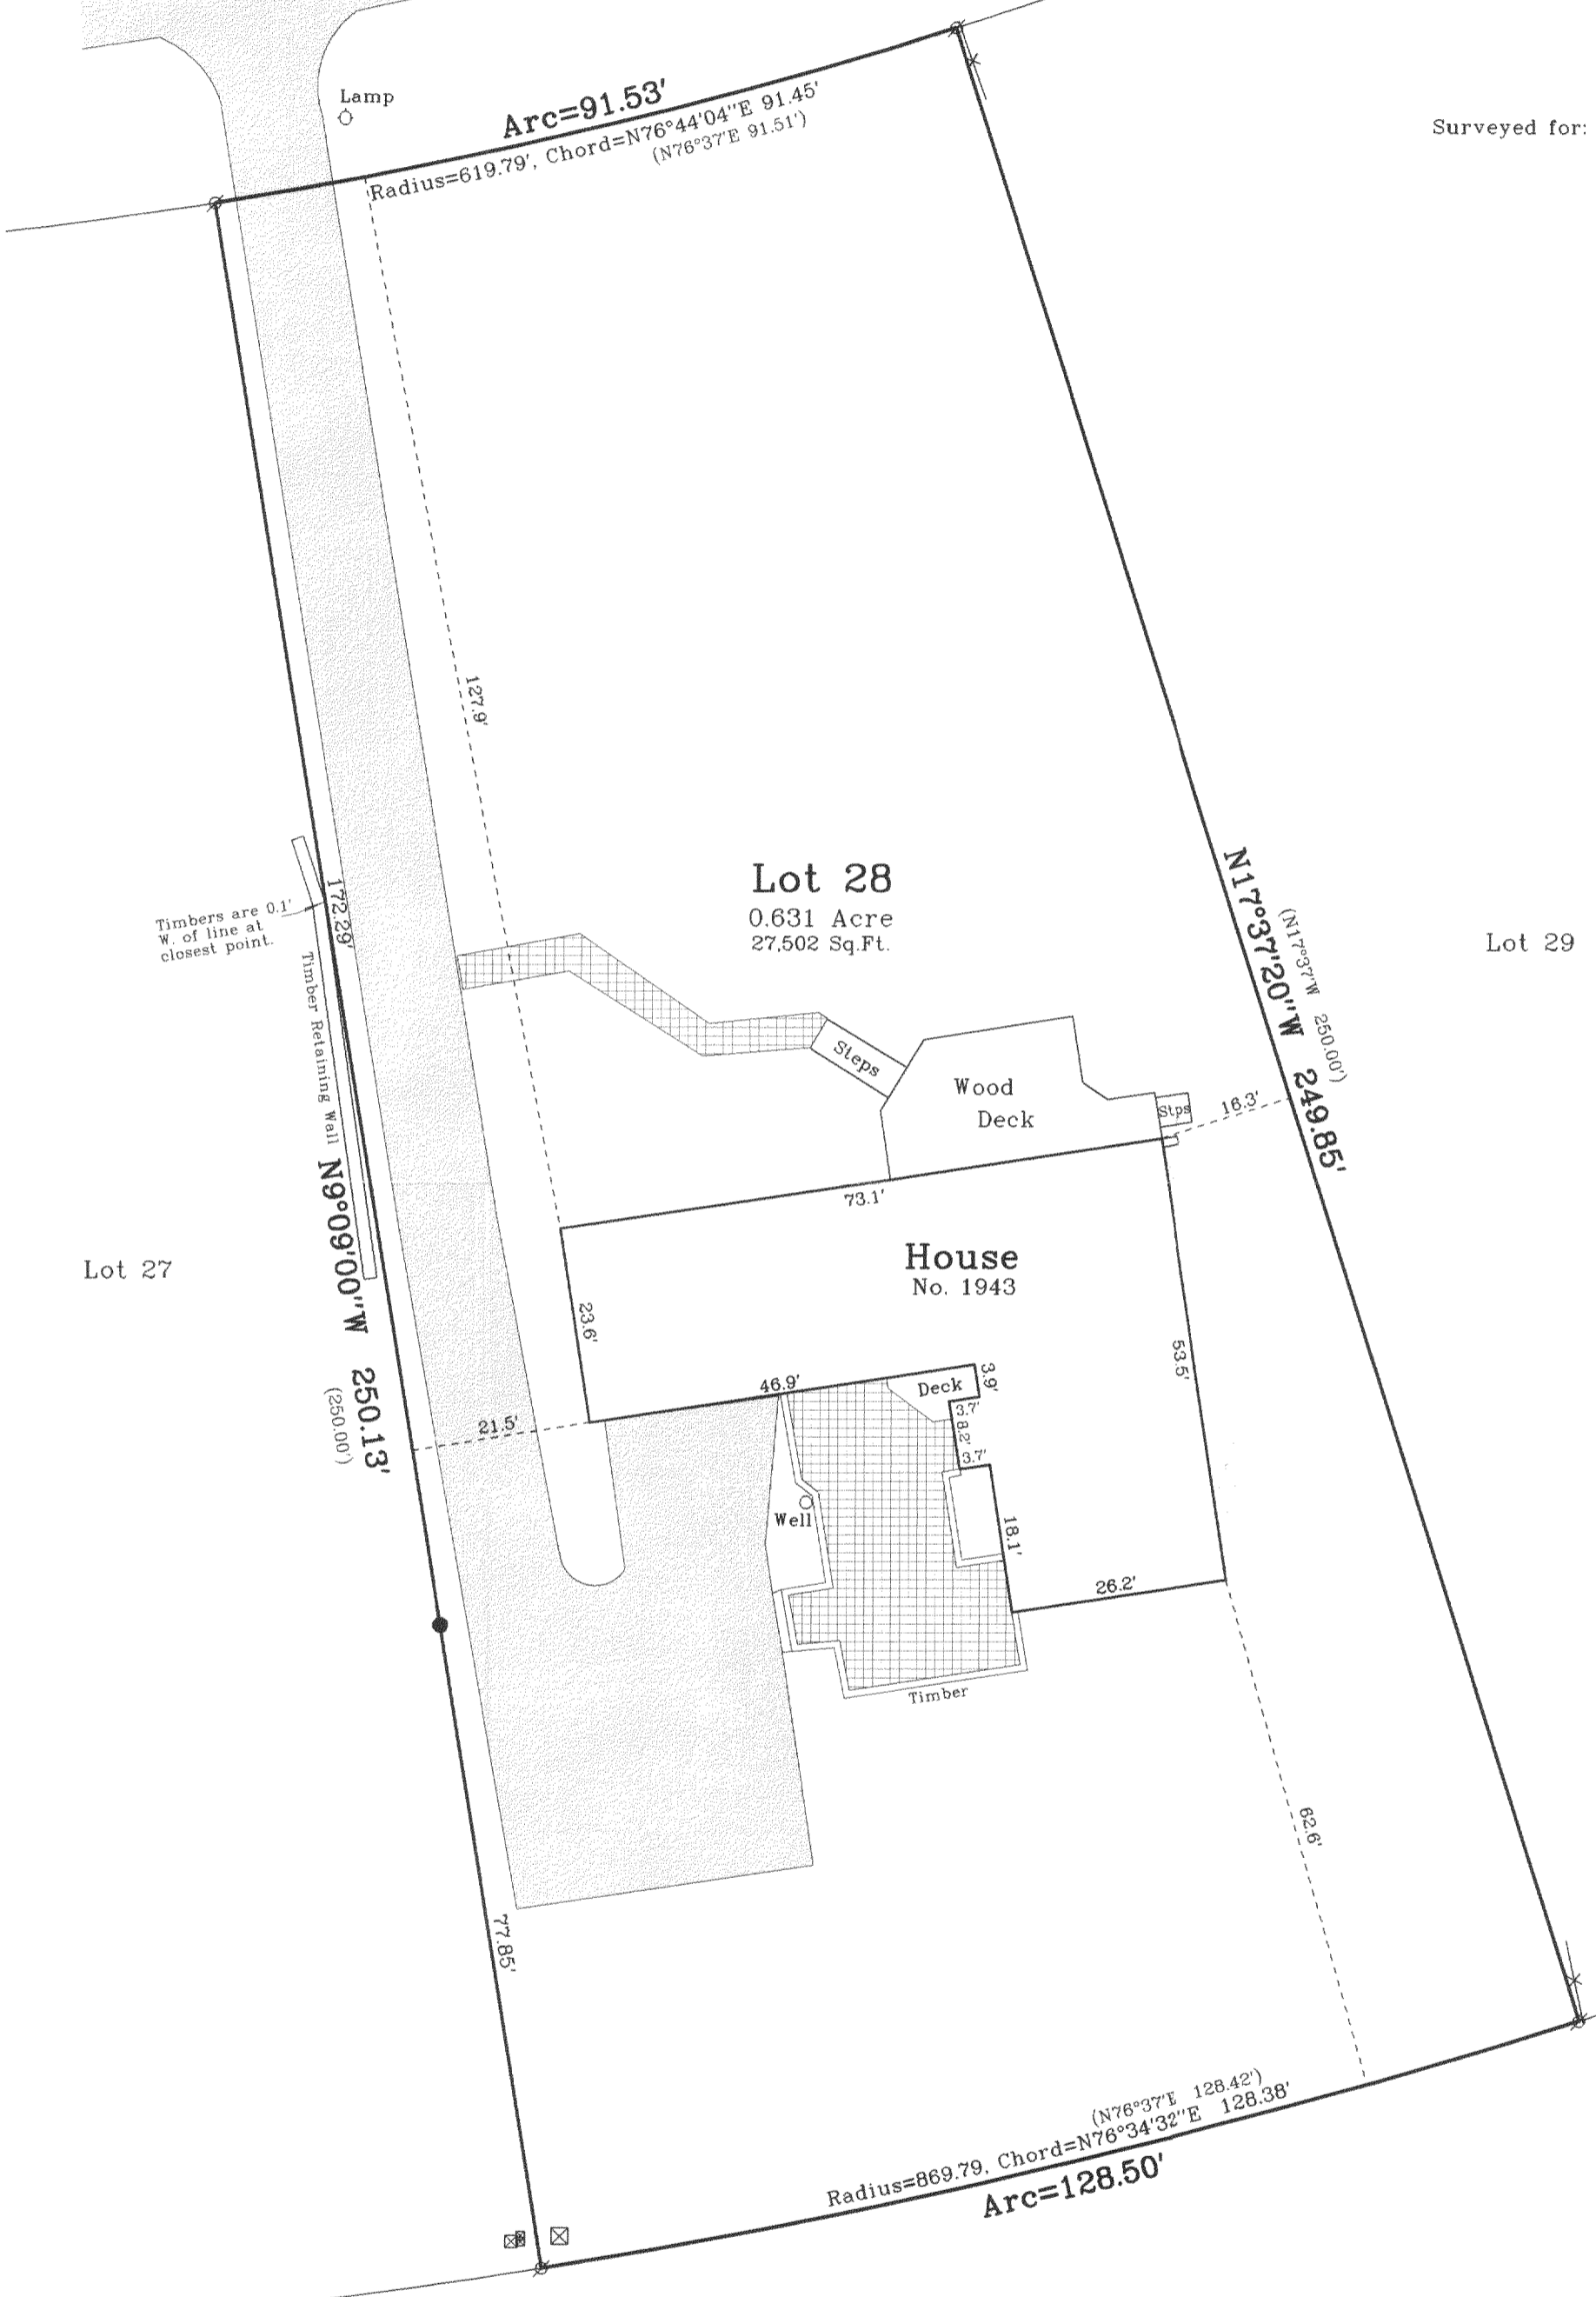



Bearings reference to the Plat of the First Addition to Lakewood Estates.

Lot 28
0.631 Acre
27,502 Sq.Ft.

Lot 29

Lot 27

House
No. 1943

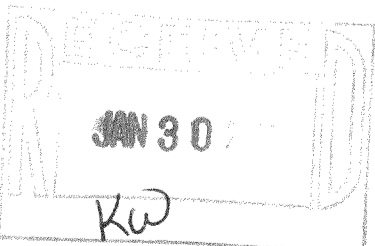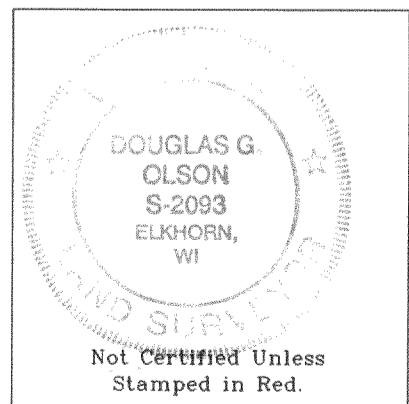

Copyright © 2003 by Jensen & Olson Land Surveying, LLC.

All rights reserved. No part of this survey plat may be reproduced or transmitted in any form by any means - graphic, electronic, or mechanical, including photocopying, tracing, or information storage and retrieval systems - without permission in writing from Douglas G. Olson, Jensen & Olson Land Surveying, LLC.

I hereby certify that I have surveyed the above described property and the map hereon is correct to the best of my professional knowledge and belief and shows the size and location of the property, its exterior boundaries, the location and dimensions of all visible structures thereon, boundary fences, apparent easements and roadways and visible encroachments, if any.
This survey is made for the exclusive use of the present owners of property, and also those who purchase, mortgage or guarantee title thereto, within one year from the date hereof.

Douglas G. Olson
Wisconsin Registered Land Surveyor - 2093

Notes:

- 1) This survey plat is not certified unless signed and sealed in red ink.
- 2) This survey is subject to Wisconsin lien laws. This Plat of Survey is the notice of intent to file lien. Lien waiver required.

Sheet 1 of 1 Sheets

Job Reference Number
2003.181

Legend

- Found Iron Pipe
- Found Iron Rod
- () Recorded Information
- ⊠ Utility Box or Pedestal
- ▨ Asphalt Surface
- ▩ Brick Surface

Jensen & Olson Land Surveying, LLC

45 South Wisconsin Street P.O. Box 322
Elkhorn, Wisconsin. 53121
Telephone (262) 723-3434
Facsimile (262) 723-8044

Scale in Feet
1" = 20'



Survey Date: November 7, 2003
Revisions:

2003.181

FLEA-8

216-3657