

ABELL
SURVEYING & MAPPING

1140 SEQUOIA STREET • DELAVAN, WISCONSIN 53115
262-728-6737

SWEET


66 FEET WIDE

ROAD

CORNER CHAINLINK FENCE IS 2.3' SOUTH AND 0.8' WEST OF LOT CORNER

DRIVE

SUMMIT

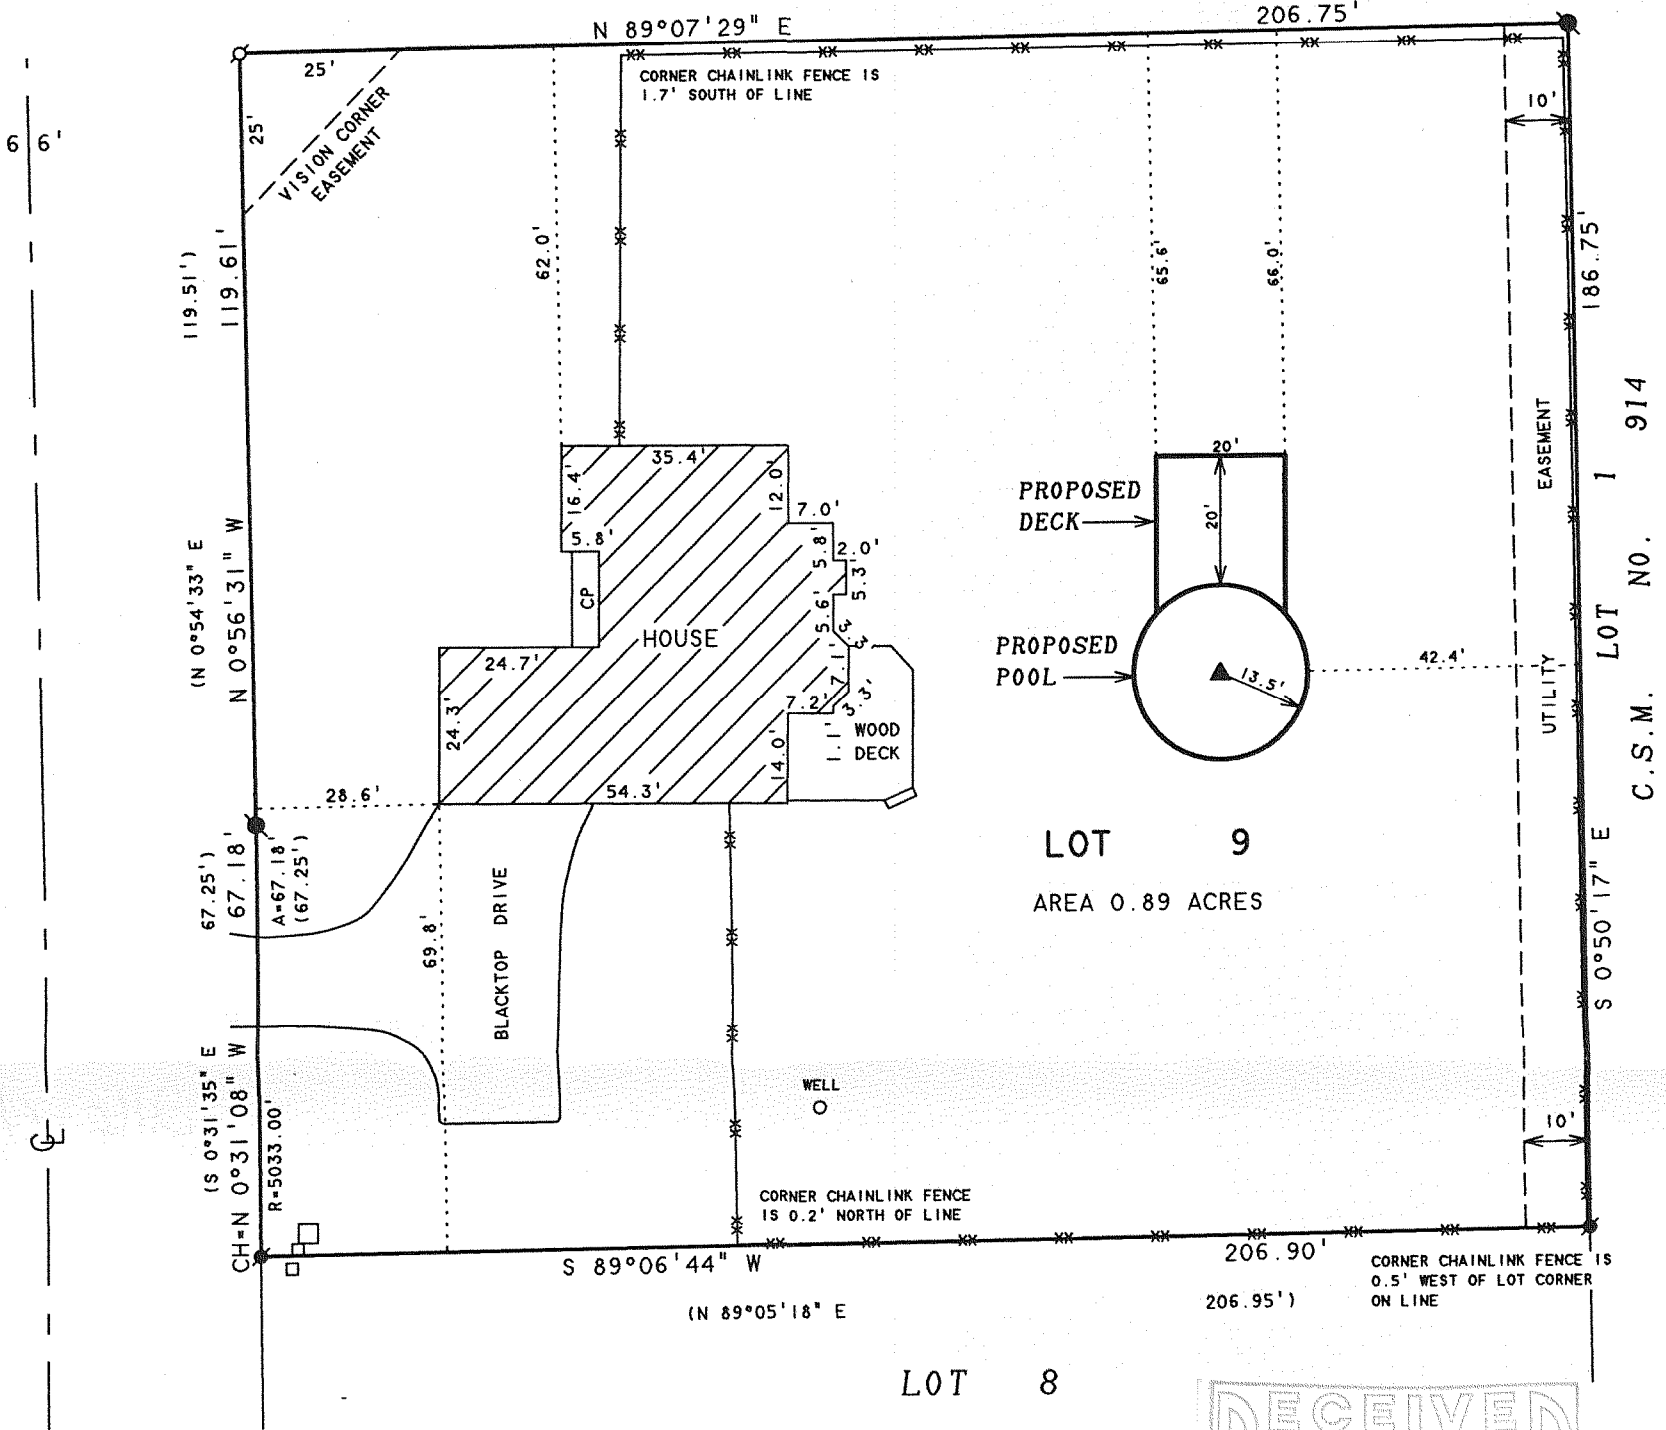

NOTE: BEARINGS ARE REFERENCED TO THE RECORDED SUBDIVISION PLAT.



SCALE 1" = 30'

LEGEND

- - IRON PIPE FOUND
- - IRON ROD FOUND
- ◐ - IRON BAR FOUND
- - UTILITY PEDS.
- CP - CONCRETE PORCH
- X---X--- - CHAINLINK FENCE
- () - RECORDED AS
- ▲ - YELLOW PLASTIC STAKE MARKING THE CENTER OF THE PROPOSED POOL

ORDERED BY: KEEFE REAL ESTATE
1155 E. GENEVA STREET
DELAVAN, WI 53115

REVISED AND RECERTIFIED JUNE 11, 2003
ORDERED BY: THE RAULAND AGENCY
P.O. BOX 159
WALWORTH, WI. 53184

REVISED: JUNE 22, 2006 TO SHOW THE PROPOSED POOL AND DECK.
ORDERED BY: MARY MABRY
7980 SUMMIT DRIVE
DELAVAN, WI 53115

PLAT OF SURVEY OF
LOT 9, SUMMIT MEADOWS SUBDIVISION, LOCATED IN
T2N, R16E, WALWORTH COUNTY, WISCONSIN.


I HEREBY CERTIFY THAT I HAVE SURVEYED THE ABOVE DESCRIBED PROPERTY AND THAT THE ABOVE MAP IS A TRUE REPRESENTATION THEREOF AND SHOWS THE SIZE AND LOCATION OF THE PROPERTY, ITS EXTERIOR BOUNDARIES, THE LOCATION OF ALL VISIBLE STRUCTURES AND DIMENSIONS OF ALL PRINCIPAL BUILDINGS THEREON, BOUNDARY FENCES, APPARENT EASEMENTS, ROADWAYS AND VISIBLE ENCROACHMENTS, IF ANY, TO THE BEST OF MY KNOWLEDGE AND BELIEF.

THIS SURVEY IS MADE FOR THE USE OF THE PRESENT OWNERS OF THE PROPERTY, AND ALSO THOSE WHO PURCHASE, MORTGAGE, OR GUARANTEE THE TITLE THERETO WITHIN ONE (1) YEAR FROM DATE HEREON.

David F. Abell
DAVID F. ABELL
WISCONSIN REGISTERED LAND SURVEYOR, S-1596

July 9, 2001

DATE JOB NUMBER - 01095B
NOTE: THIS IS NOT A CERTIFIED COPY UNLESS SEALED.

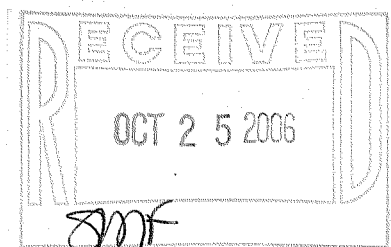

FSM-9

216-4269