

PLAT OF SURVEY


— WORK ORDERED BY —  
STEBNITZ BUILDERS  
1102 ANN STREET  
DELAVAN, WI. 53115

FARRIS, HANSEN & ASSOCIATES, INC.  
ENGINEERING — ARCHITECTURE — SURVEYING  
7 RIDGWAY COURT P.O. BOX 437  
ELKHORN, WISCONSIN 53121  
OFFICE: (262) 723-2098 FAX: (262) 723-5886

REVISIONS  
03/23/2007-KD  
TO SHOW SIZE AND  
LOCATION OF  
PROPOSED ADDITION  
7/11/2007-KB  
TO SHOW SIZE AND  
LOCATION OF AS-BUILT  
ADDITION & DECK

PROJECT NO.  
5866  
DATE  
08/21/01  
SHEET NO.  
1 OF 1

PLAT OF SURVEY  
LOT 2 OF THE ADDITION TO WILLOW POINT PARK  
LOCATED IN THE SE 1/4 OF SECTION 29, TOWN 2 NORTH, RANGE 16 EAST  
WALWORTH COUNTY, WISCONSIN

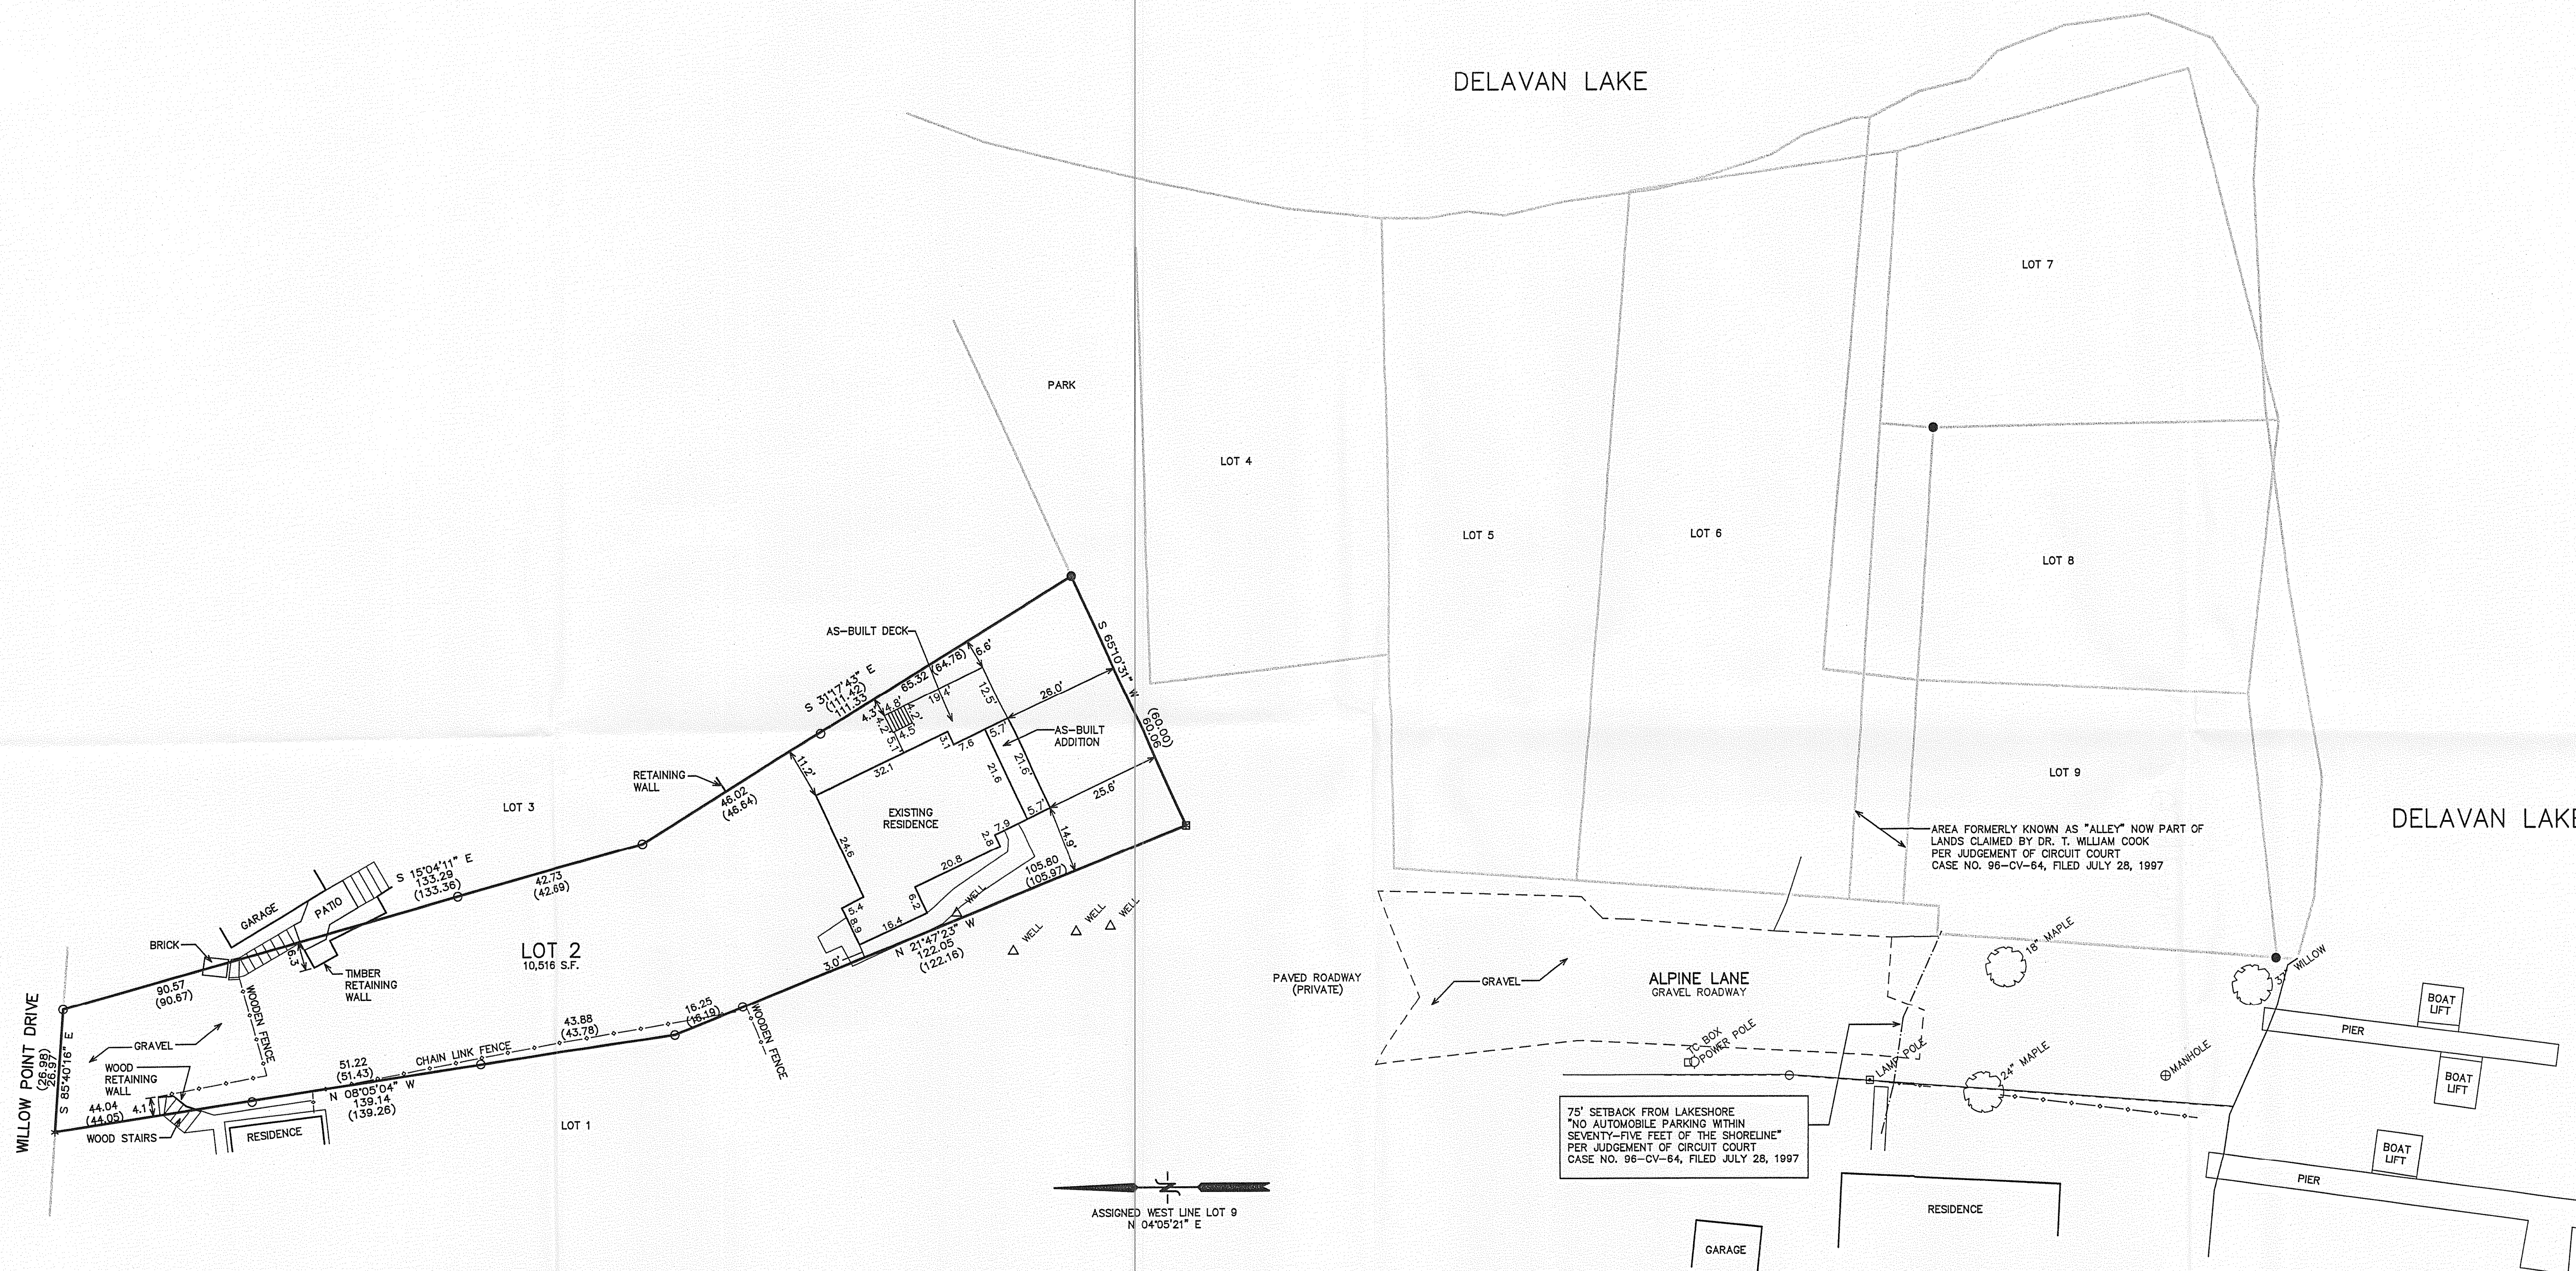


10 5 0 10 20 30 40 50 60 70 80 90 100  
MAP SCALE IN FEET ORIGINAL 1" = 20'

LEGEND  
\* = SET NAIL  
O = FOUND IRON PIPE STAKE  
● = FOUND IRON REBAR STAKE  
■ = SET LANDSCAPE SPIKE IN CONCRETE MONUMENT  
(XXX) = RECORDED AS

NOTE: COPIES OF THIS MAP TO WHICH THE FOLLOWING CERTIFICATE WILL APPLY SHOW SURVEYOR'S ORIGINAL SEAL AND SIGNATURE IN RED INK. COPIES BY ANY OTHER MEANS MAY HAVE ALTERATIONS WHICH DO NOT REPRESENT THE SURVEYOR'S WORK PRODUCT.

I HEREBY CERTIFY THAT THE ABOVE DESCRIBED PROPERTY HAS BEEN SURVEYED UNDER MY DIRECTION AND THAT THE ABOVE MAP IS A TRUE REPRESENTATION THEREOF AND SHOWS THE SIZE AND LOCATION OF THE PROPERTY AND ITS EXTERIOR BOUNDARIES. THIS SURVEY IS MADE FOR THE USE OF THE PRESENT OWNERS OF THE PROPERTY, AND ALSO THOSE WHO PURCHASE, MORTGAGE, OR GUARANTEE THE TITLE THERETO WITHIN ONE YEAR FROM THE DATE HEREOF.

DATED: 08/22/2001  
REVISED 03-26-2007  
TO SHOW SIZE & LOCATION OF  
PROPOSED IMPROVEMENTS  
PETER S. GORDON R.L.S. 2101

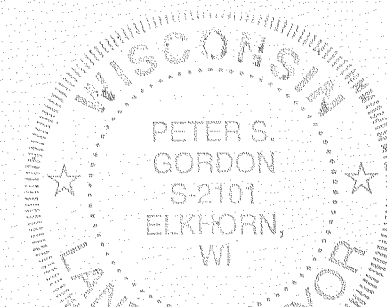

FWIA-1A