


DUNHAM SURVEYING, S.C.
SURVEYING & SUBDIVIDING
DELAVER, WISCONSIN 53115

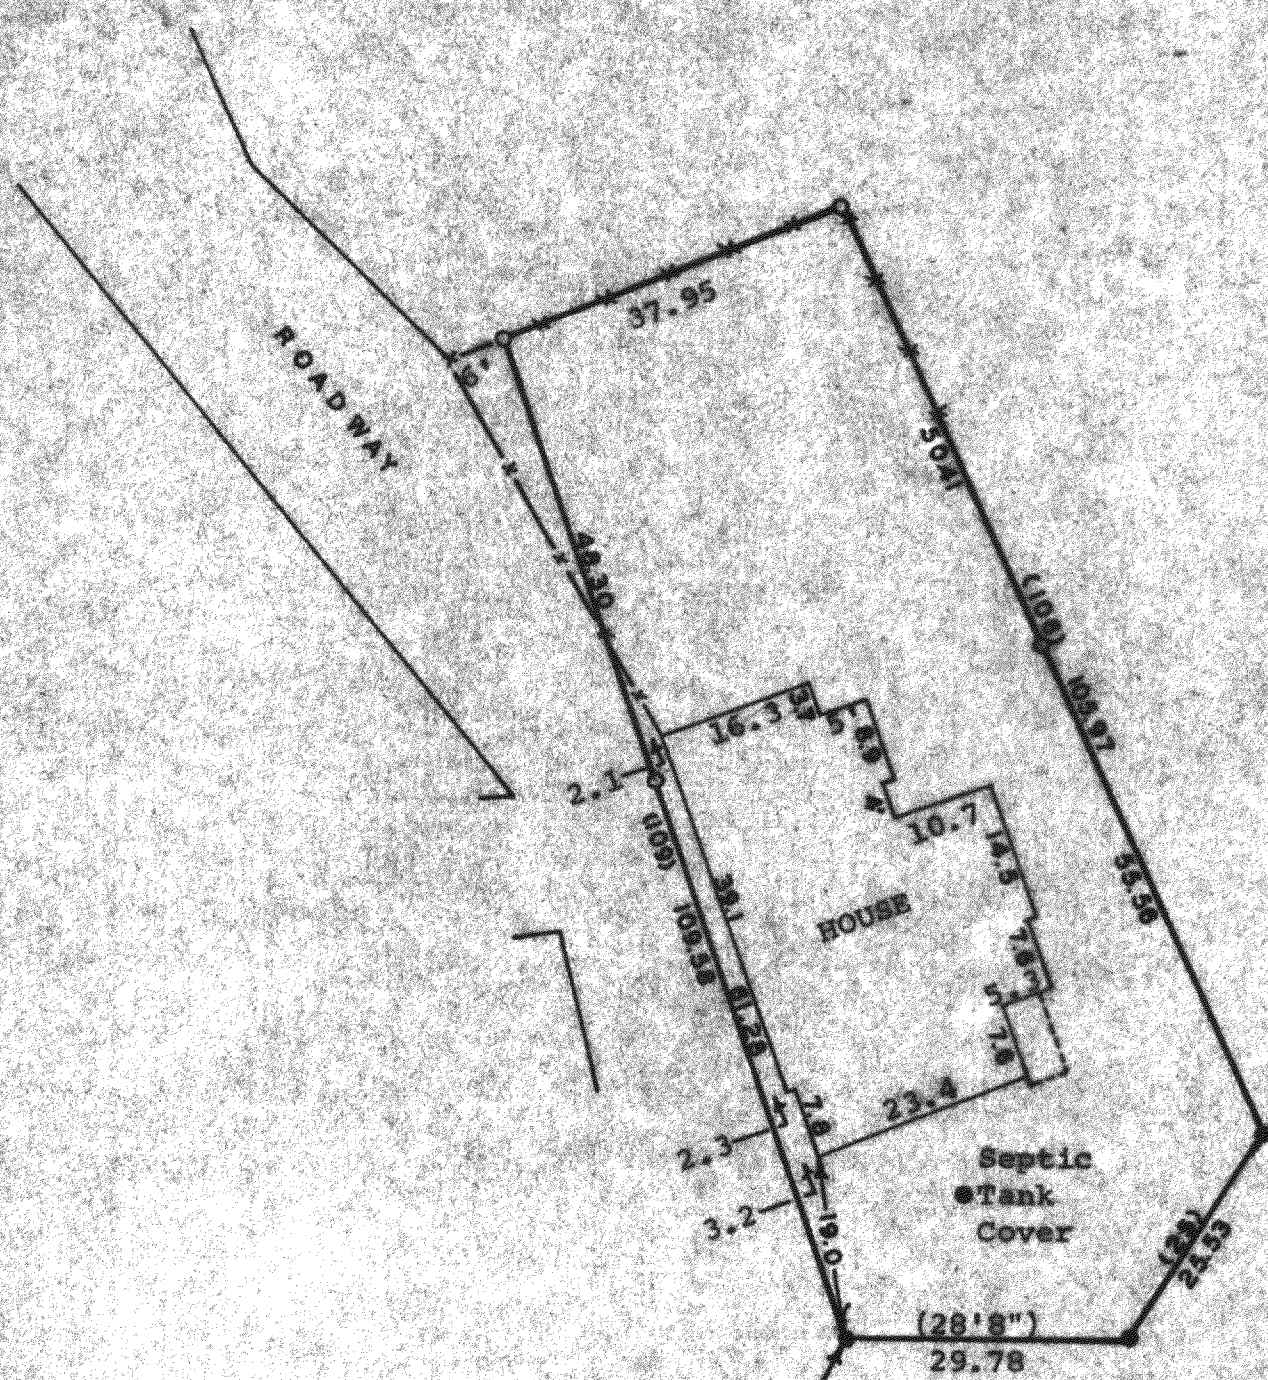

Southwesterly corner of Lot 1
of the Addition to Willow Point
Park.

STATE OF WISCONSIN) ss
COUNTY OF WALWORTH)

I, George T. Dunham, Surveyor, certify that I have surveyed the
property described as follows,


A part of Lot 1 of the Addition to Willow Point Park located in
Section 29, T 2 N, R 16 E, Walworth County, Wisconsin, described
as follows: Beginning at a point on the Westerly line of said
lot, which point is 109.58 feet (recorded as 109 feet) northwesterly
of the southwesterly corner of said lot; thence Southeasterly
along the Westerly line of said lot 109.58 feet to the southwesterly
corner thereof; thence Easterly 29.78 feet, along the southerly
line of said lot to a concrete monument; thence northeasterly 25.53
feet (recorded as 25 feet) to a concrete monument at the south-
easterly corner of said Lot 1; thence Northwesterly along the
Easterly line of said lot 105.97 (recorded as 106 feet) to a point;
thence westerly 37.95 feet to the place of beginning.

and the above map is a true representation thereof and shows the size and
location of the property, its exterior boundaries, the location and dimensions
of all structures thereon, fences, apparent easements and roadways and
visible encroachments, if any.

This survey is made for the exclusive use of the present owners of the
property, and also those who purchase, mortgage, or guarantee the title
thereto within one (1) year from date hereof; and as to them I warrant the
accuracy of said survey and map.

September 13, 1978

George T. Dunham
George T. Dunham, Surveyor

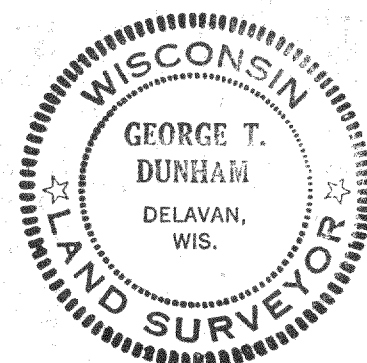

FWIA-1

FWIA-1

216-448