
PREPARED FOR: BRUCE KAMP

## PLAT OF SURVEY

- OF -

PATHFINDER SURVEYING INC. (formerly) J.K. SURVEYING INC. P.O. BOX 322 LAKE GENEVA, WI. 262-248-8303

LOT 19 OF WOODLAND SHORES SUBDIVISION, LOCATED IN TOWN 2 NORTH, RANGE 16 EAST OF THE FOURTH PRINCIPAL MERIDIAN, TOWN OF DELAVAN, COUNTY OF WALWORTH COUNTY, STATE OFWISCONSIN

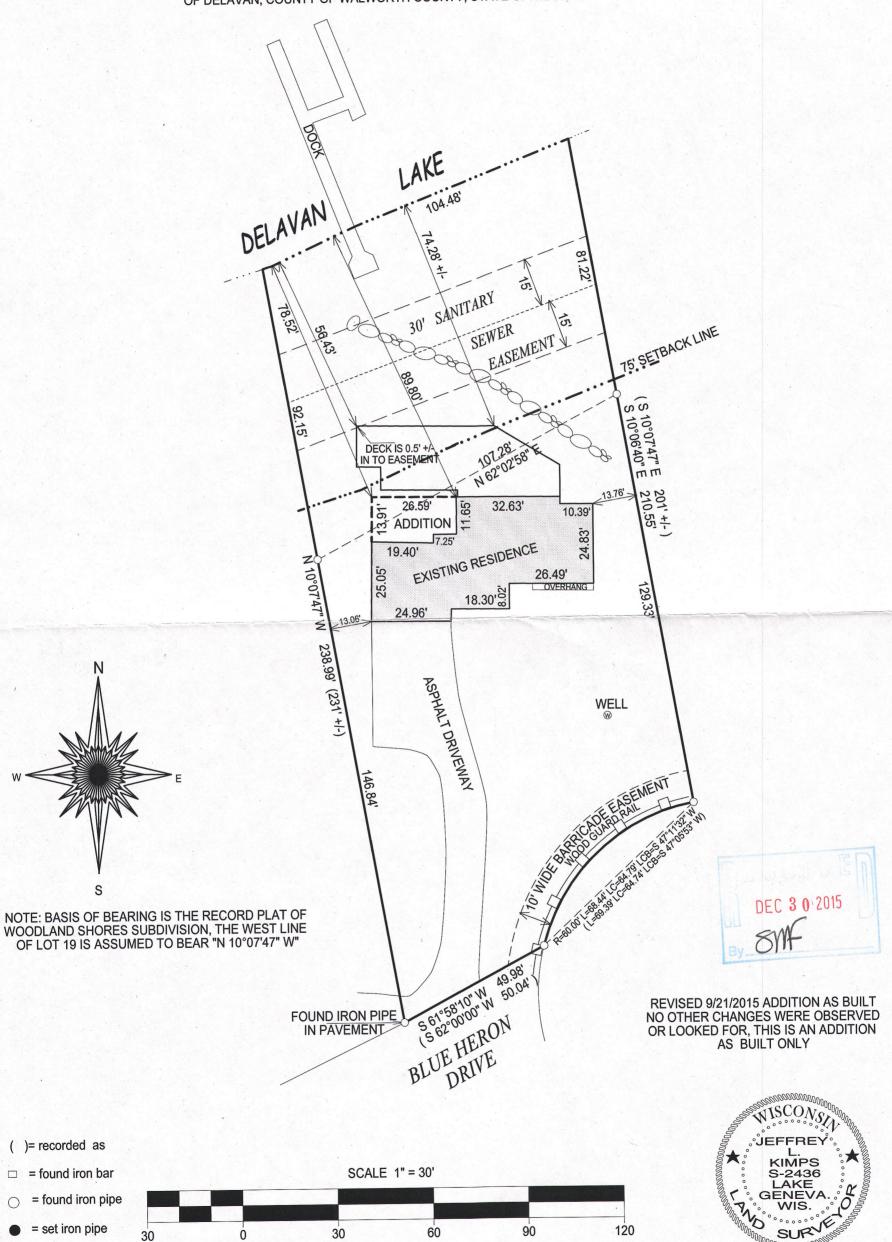

JOB #10-175

TAX ID # FWLS 00019

= set iron bar

"I hereby certify that I have surveyed the above described property and that the above map is a true representation of its exterior boundary and shows the size and location of all visible structures, apparent easements and encroachments if any."

This survey is made for the present owners of the property, and those who purchase, mortgage, or guarantee the title thereto, within one year from the date hereof.

DATED THIS 7th, DAY OF DECEMBER, 2010.



JEFFREY L KIMPS S - 2436 Wisconsin Registered Land Surveyor ( original if signed in red )

60,10