


PLAT OF SURVEY OF LOT 2 OF THE BRINK SUBDIVISION  
 Located in Section 27, Town 2 North, Range 16 East,  
 Walworth County, Wisconsin

I HEREBY CERTIFY that this Plat of Survey is a true and accurate representation of the lot lines and buildings located thereon to the best of my professional knowledge and belief. I further certify that this survey is a retracement of an earlier survey of the same parcel by George Dunham dated September 1958, said survey being on file in the office of the Walworth County Surveyor.

Dated this 29th day of October, 1980

*Robert A. Farris*  
 Robert A. Farris RLS

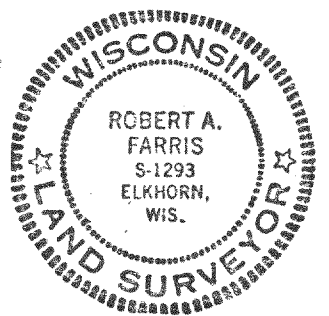

**FARRIS, HANSEN & COOPER, INC.**  
 ENGINEERING, SURVEYING AND LAND PLANNING  
 715 W. WALWORTH ST. - P.O. BOX 487 - ELKHORN, WI 53120

FBS-2

PROJECT 1769  
 216-741F