

KOLB LAND CONSULTING, INC.  
 LAND SURVEYING · SUBDIVIDING · LAND PLANNING


LAKE GENEVA, WISCONSIN 53147

WHITEWATER, WISCONSIN 53190

GENEVA LAKE

SHORELINE DISTANCE = 41.4'  
 CONCRETE SEAWALL

16' CUT CROSS

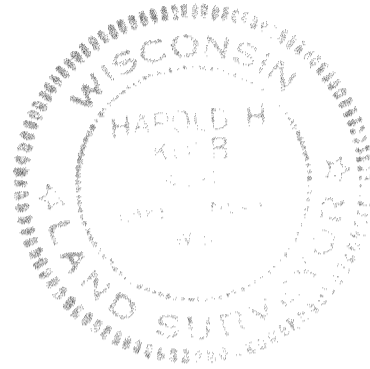

1.7' 2.8' CUT CROSS IN SEAWALL (10/6/82)

NOTE: FOUND CUT CROSS, SHOWN ON PLAT OF SURVEY BY LLOYD JENSEN DATED SEPT. 1947, 0.47' WEST OF LINE. SEAWALL IS LEANING INTO LAKE. DISTANCE TO MARK IS 0.77' LONG.

RAILROAD TIE RETAINING WALL

33.4' 56.06'

NOTE: FOUND MARK FROM IRON PIPE SHOWN ON PLAT OF SURVEY BY GEORGE DUNHAM DATED OCTOBER, 1969 AND BY LLOYD JENSEN DATED SEPT. 1947

0.7' 37.41' 210.42'

SOUTHWEST CORNER OF LOT 19 OF BARNES & VON SUESSMILCH SUB.



SCALE: 1"=10'

- o - IRON PIPE FOUND
- ( ) - RECORDED AS
- - CONCRETE MONUMENT FOUND

PLAT OF SURVEY OF

PART OF LOTS 14 AND 15 OF BARNES & VON SUESSMILCH SUBDIVISION, T 2 N, R 16 E, WALWORTH COUNTY, WISCONSIN.

ORDERED BY: DONALD BECK  
 3505 SOUTH SHORE DRIVE  
 DELAVAN, WISCONSIN 53115

I, HAROLD H. KOLB, DO HEREBY CERTIFY THAT I HAVE SURVEYED THE PROPERTY HEREON DESCRIBED ACCORDING TO THE OFFICIAL RECORDS, AND THAT THE PLAT HEREON IS A CORRECT REPRESENTATION OF THE LOT LINES TO THE BEST OF MY KNOWLEDGE AND BELIEF.

*Harold H. Kolb*

HAROLD H. KOLB  
 WISCONSIN REGISTERED LAND SURVEYOR, S-187

DATE Oct. 7, 1982