


DUNHAM SURVEYING, S.C.
SURVEYING & SUBDIVIDING
DELAVER, WISCONSIN 53115

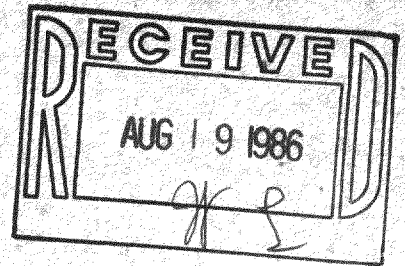


Scale - 1" = 30'

- = 1" Iron Rod Found
- ✕ = 2" Iron Pipe Found
- ✕ = 1 1/2" Iron Pipe Found
- ✕ = 1" Iron Pipe Found
- = 1/2" Iron Pipe Set

(0.00) = recorded distance
Bearings referenced to the assumed
bearing of East along the south line
of the roadway

Owner: Ernest J. Cwik
2814 Willow Point Drive
Delavan, WI 53115

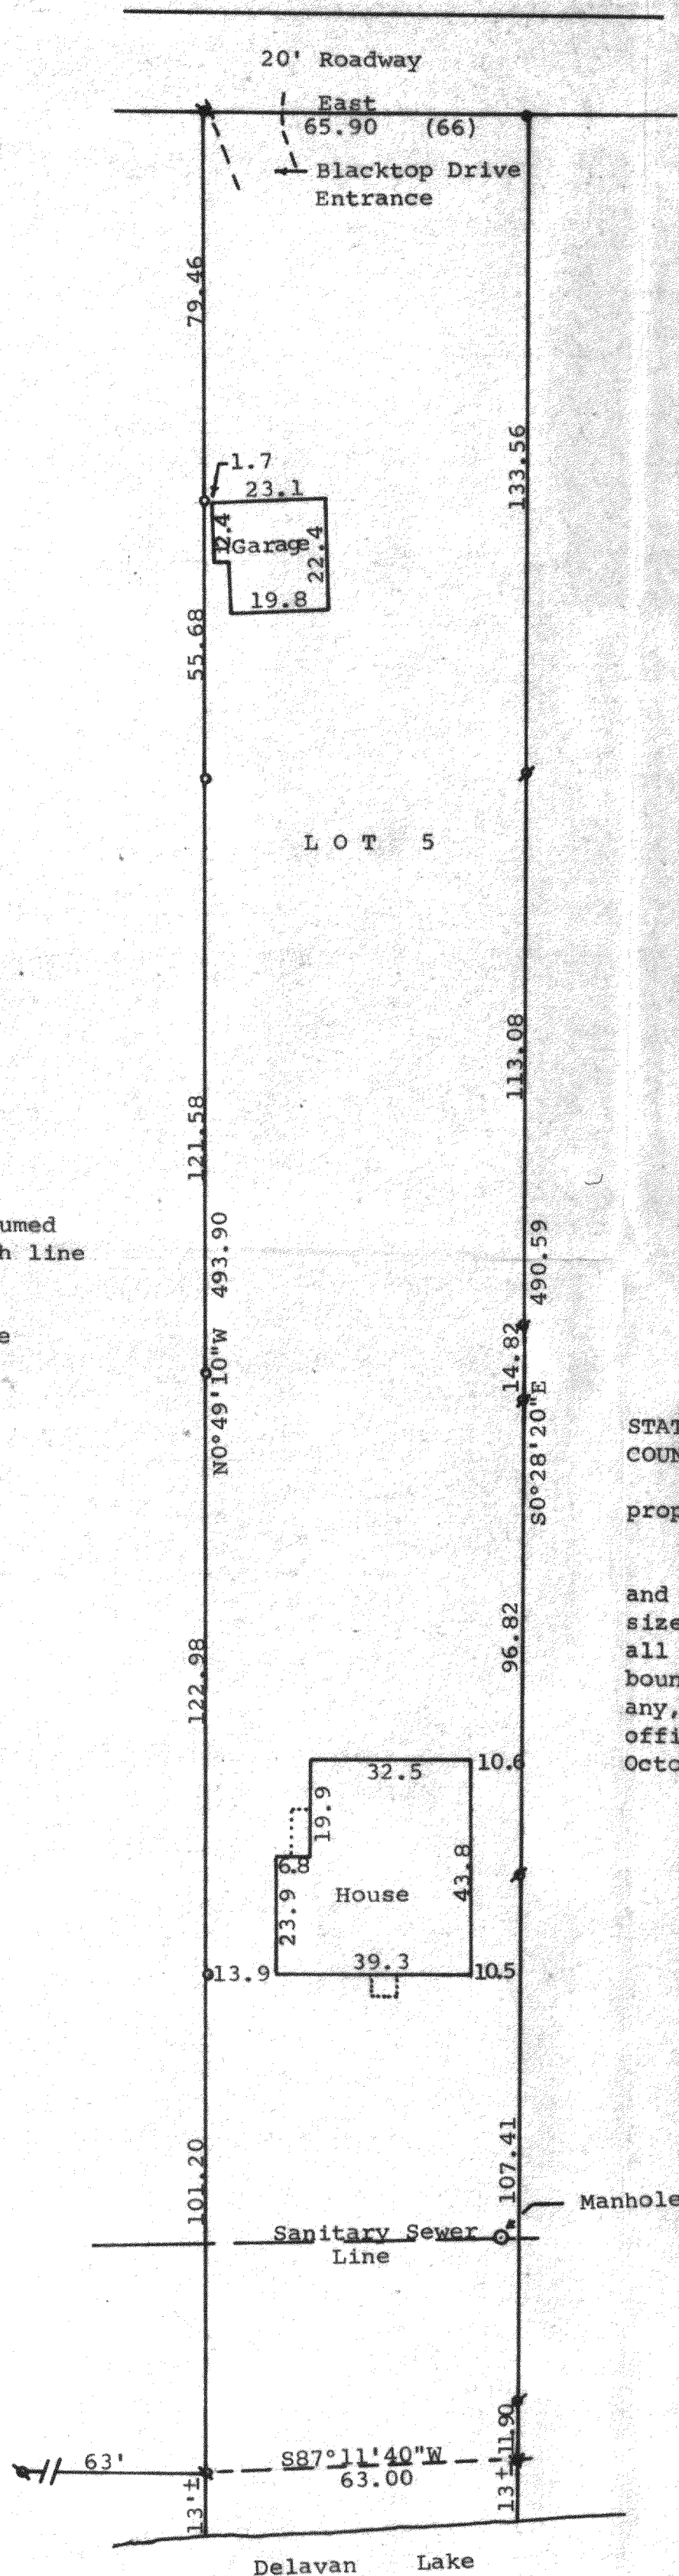

STATE OF WISCONSIN)
COUNTY OF WALWORTH) SS

I, George T. Dunham, Surveyor, certify that I have surveyed the
property described as follows:

Lot 5 of the Hamlet of Bon Secour, located in Section 29, T 2 N,
R 16 E, Walworth County, Wisconsin,

and that the plat shown hereon is a true representation thereof and shows the
size and location of the property, its exterior boundaries, the location of
all visible structures and dimensions of all principal buildings thereon,
boundary fences, apparent easements, roadways and visible encroachments, if
any, and that I have surveyed the property hereon described according to the
official records to the best of my knowledge and belief.
October 20, 1984

George T. Dunham
George T. Dunham, Surveyor

