

NOTE: THIS IS NOT A CERTIFIED COPY UNLESS SEALED.

DATE August 17, 1987 JOB NUMBER - 87113

WISCONSIN REGISTERED LAND SURVEYOR, S-1596


DAVID F. ABELL

David F. Abell

I, DAVID F. ABELL, DO HEREBY CERTIFY THAT I HAVE SURVEYED THE PROPERTY HEREON DESCRIBED ACCORDING TO THE OFFICIAL RECORDS AND THAT THE PLAT HEREON IS A CORRECT REPRESENTATION OF THE PROPERTY LINES TO THE BEST OF MY KNOWLEDGE AND BELIEF.

LEGEND
⊙ - IRON PIPE FOUND
() - RECORDED AS

SCALE - 1"=30'

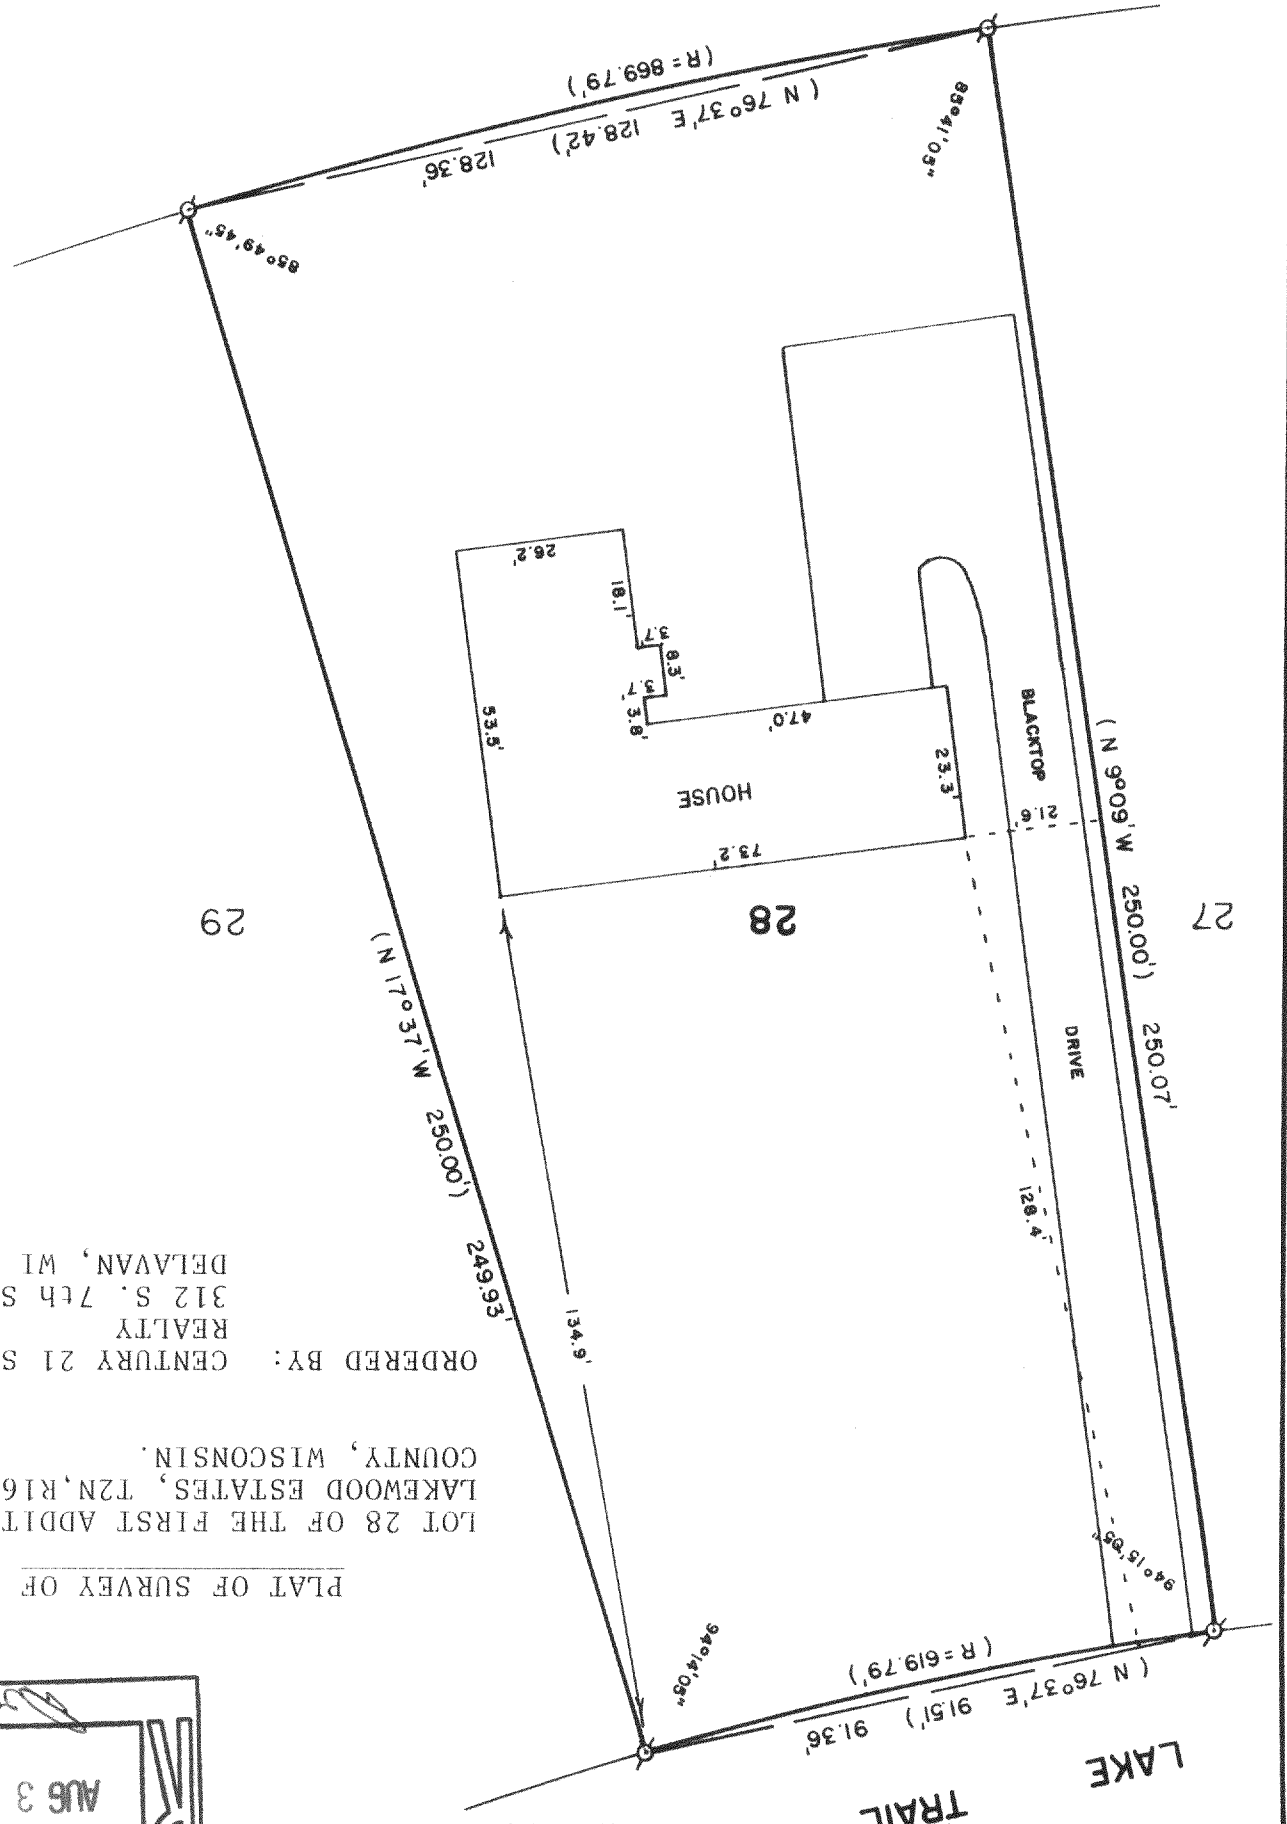

LOT 28 OF THE FIRST ADDITION TO LAKEWOOD ESTATES, T2N, R16E, WALWORTH COUNTY, WISCONSIN.

PLAT OF SURVEY OF

ORDERED BY: CENTURY 21 SKANDIA REALTY
312 S. 7th STREET
DELAVAN, WI 53115

ABELL
SURVEYING & MAPPING
DELAVAN, WISCONSIN 53115
414-728-6737

