

LOWRY HALL ROAD

24.75'

183'

STATE TRUNK HIGHWAY 50

S. SHR DRIVE

Geopost Rack

STORE

46.8'

33.5'

42.4'

54.5'

97.4'

37'



132'

50.6'

54.6'

35.1'

33.9'

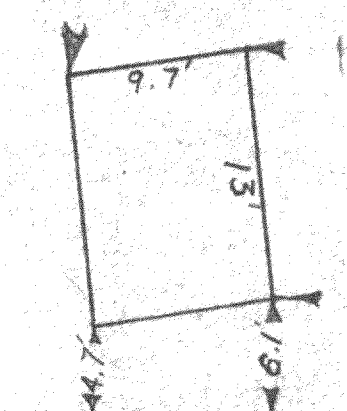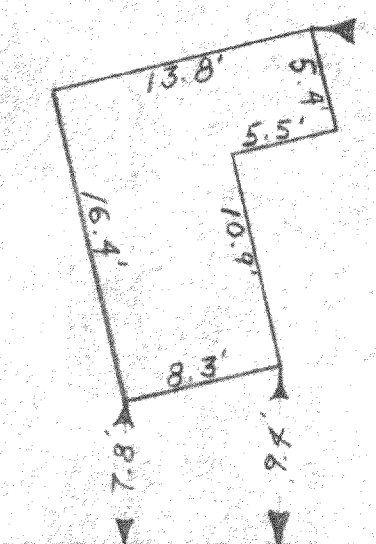

SCALE 1" = 10'

D-22-10  
216-101.1