


JONES STREET

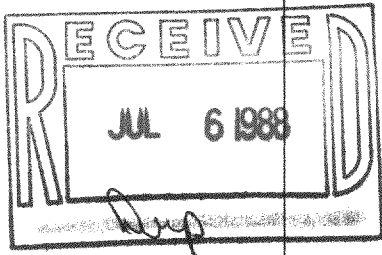

216-1038