

DUNHAM SURVEYING, S.C.
SURVEYING & SUBDIVIDING
DELAVAN, WISCONSIN 53115

N

Scale - 1" = 30'


- = Concrete Monument Found
- ⊙ = 1 1/4" Iron Pipe Found
- ⊘ = 1" Iron Pipe Found
- ⊗ = 1 1/4" Iron Pipe Found bent and reset it
- = 1" Iron Pipe Found bent and reset it

Bearings used are those shown on the recorded plat of Sunny Dell Subdivision
Survey ordered by: Century 21, Skandia Realty
312 South 7th Street
Delavan, WI 53115

STATE OF WISCONSIN)
COUNTY OF WALWORTH)

I, George T. Dunham, Surveyor, certify that I have surveyed the property described as follows:

Lots 1, 2, 3, 4, 5, 6, and 7 in Block 3 of Sunny Dell Subdivision located in Government Lot 1, The Fractional NE 1/4 of the Fractional Southeast 1/4 of Fractional Section 32, T 2 N, R 16 E, Walworth County, Wisconsin, and that the plat shown hereon is a correct representation thereof and shows the size and location of the property, its exterior boundaries, the location of all visible structures and dimensions of all principal buildings thereon, boundary fences, apparent easements, roadways and visible encroachments, if any, and that I have surveyed the property hereon described, according to the official records, to the best of my knowledge and belief.
March 14, 1988

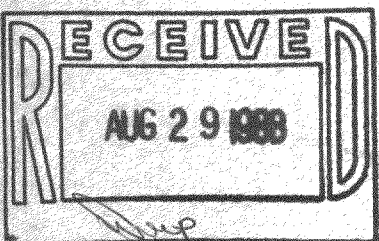

George T. Dunham
George T. Dunham, Surveyor

