

DUNHAM SURVEYING, S. C.
 SURVEYING & SUBDIVIDING
 DELAVAN, WISCONSIN 53115

N




Scale - 1" = 20'

⊘ = 1" Iron Pipe Found
 ○ = 3/4" Iron Pipe Found

Bearings referenced to the assumed bearing of
 S0°27'20"W along the westerly line of Lots 181
 and 182.

Owners: Terry & Kathy Welch
 Delavan, WI 53115

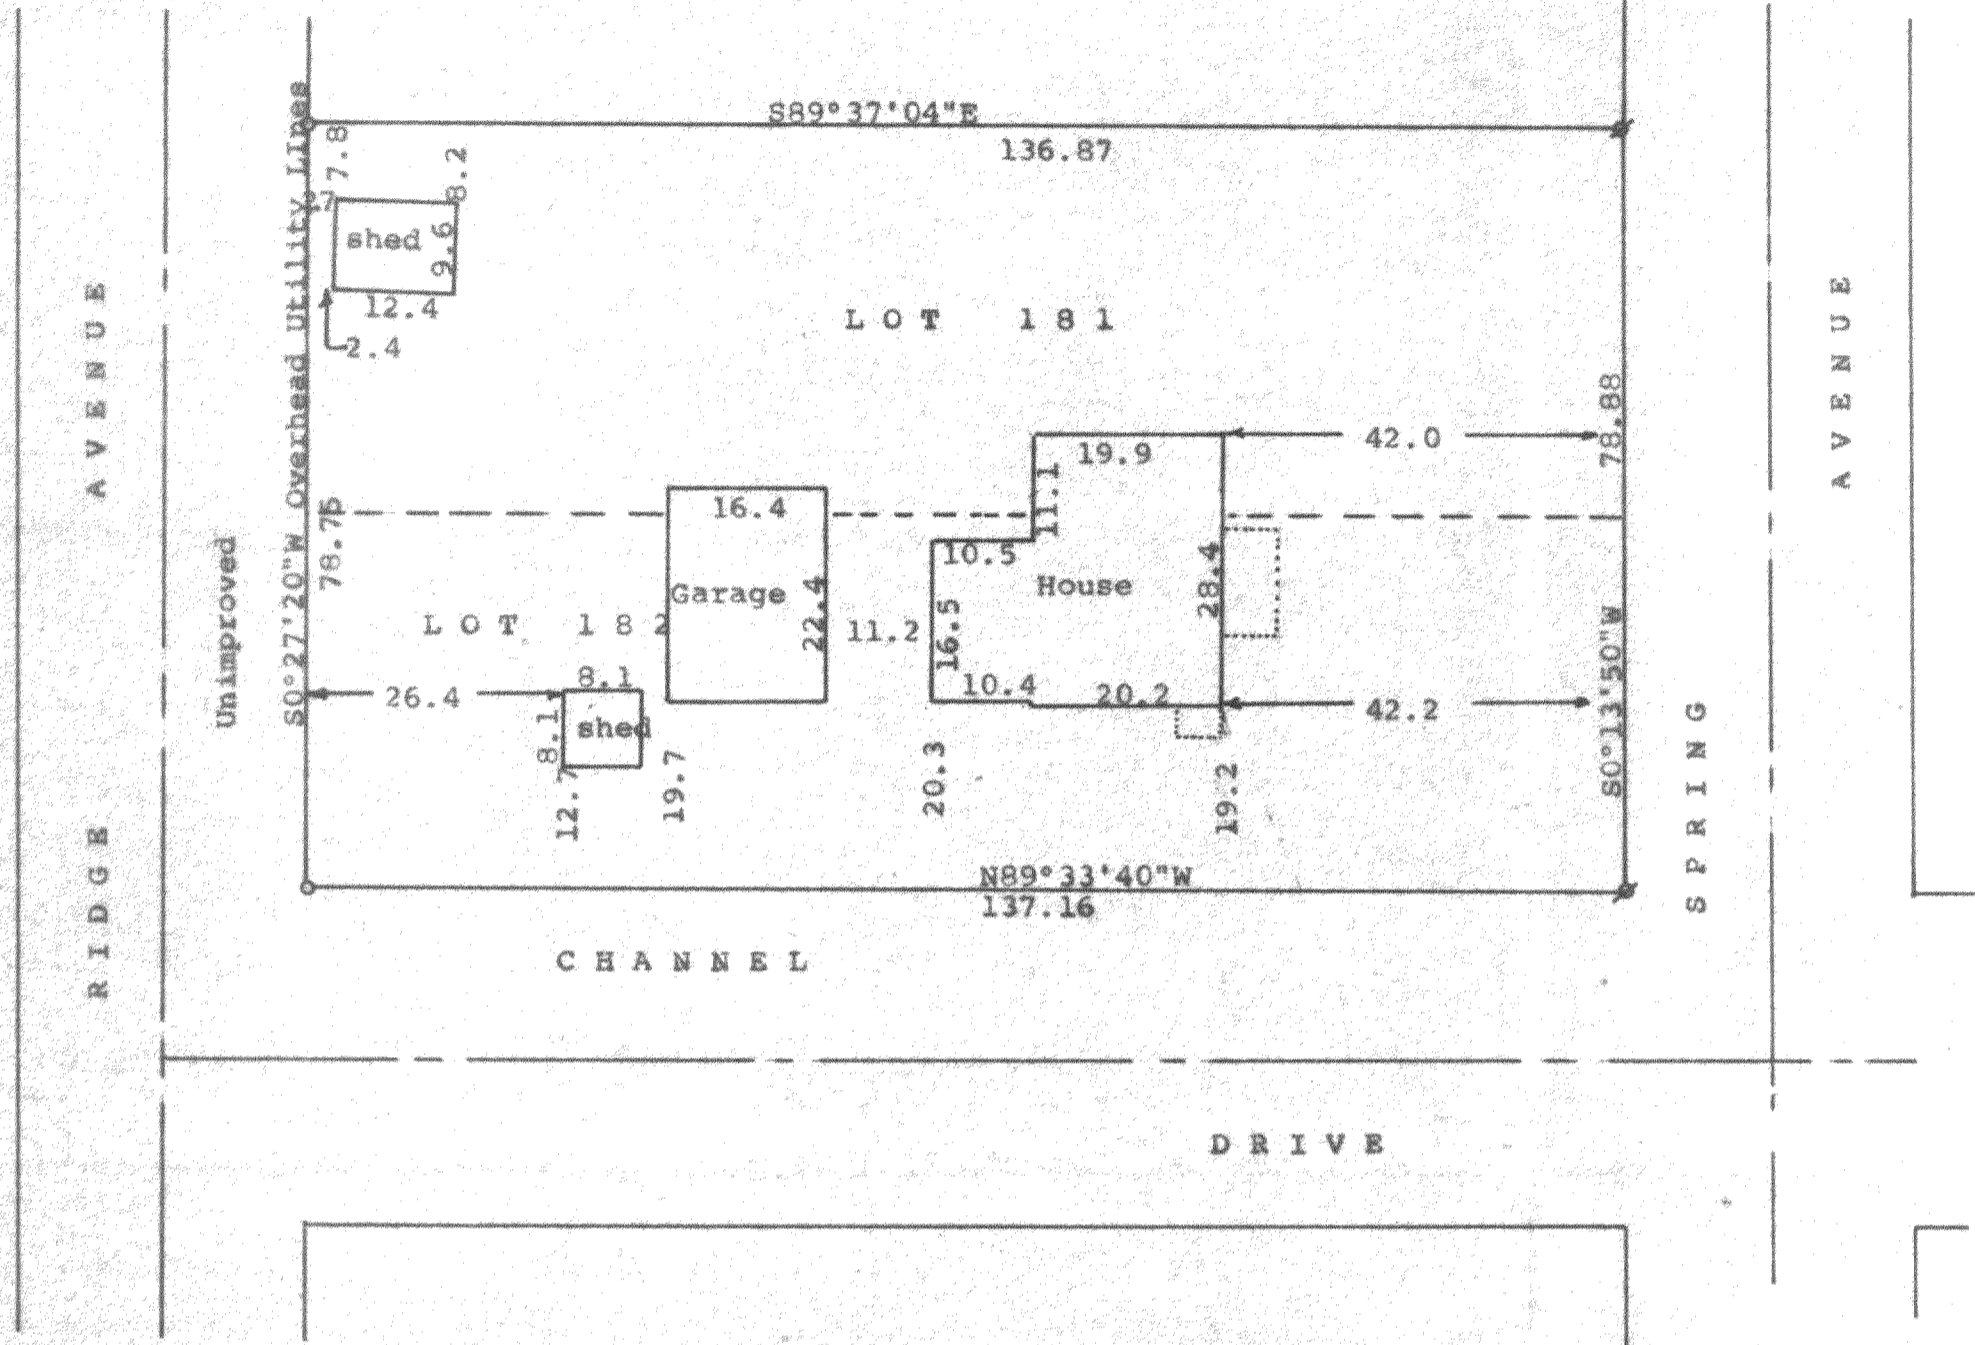


STATE OF WISCONSIN)
 COUNTY OF WALWORTH) SS

I, George T. Dunham, Surveyor, certify that I have surveyed the property described as follows:

Lots 181 and 182 in Lake Delavan Highlands, a subdivision located in the South 1/4 of the SE 1/4 of Section 31, T 2 N, R 16 E, Walworth County, Wisconsin, and that the plat shown hereon is a correct representation thereof and shows the size and location of the property, its exterior boundaries, the location of all visible structures and dimensions of all principal buildings thereon, boundary fences, apparent easements, roadways and visible encroachments, if any, and that I have surveyed the property hereon described according to the official records, to the best of my knowledge and belief.

March 29, 1988

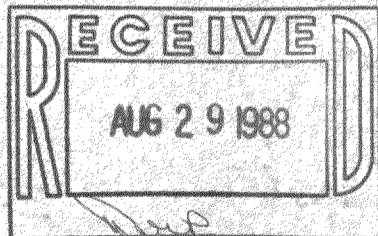

George T. Dunham
 George T. Dunham, Surveyor

