



ABELL
SURVEYING & MAPPING
DELAVER, WISCONSIN 53115
414-728-6737

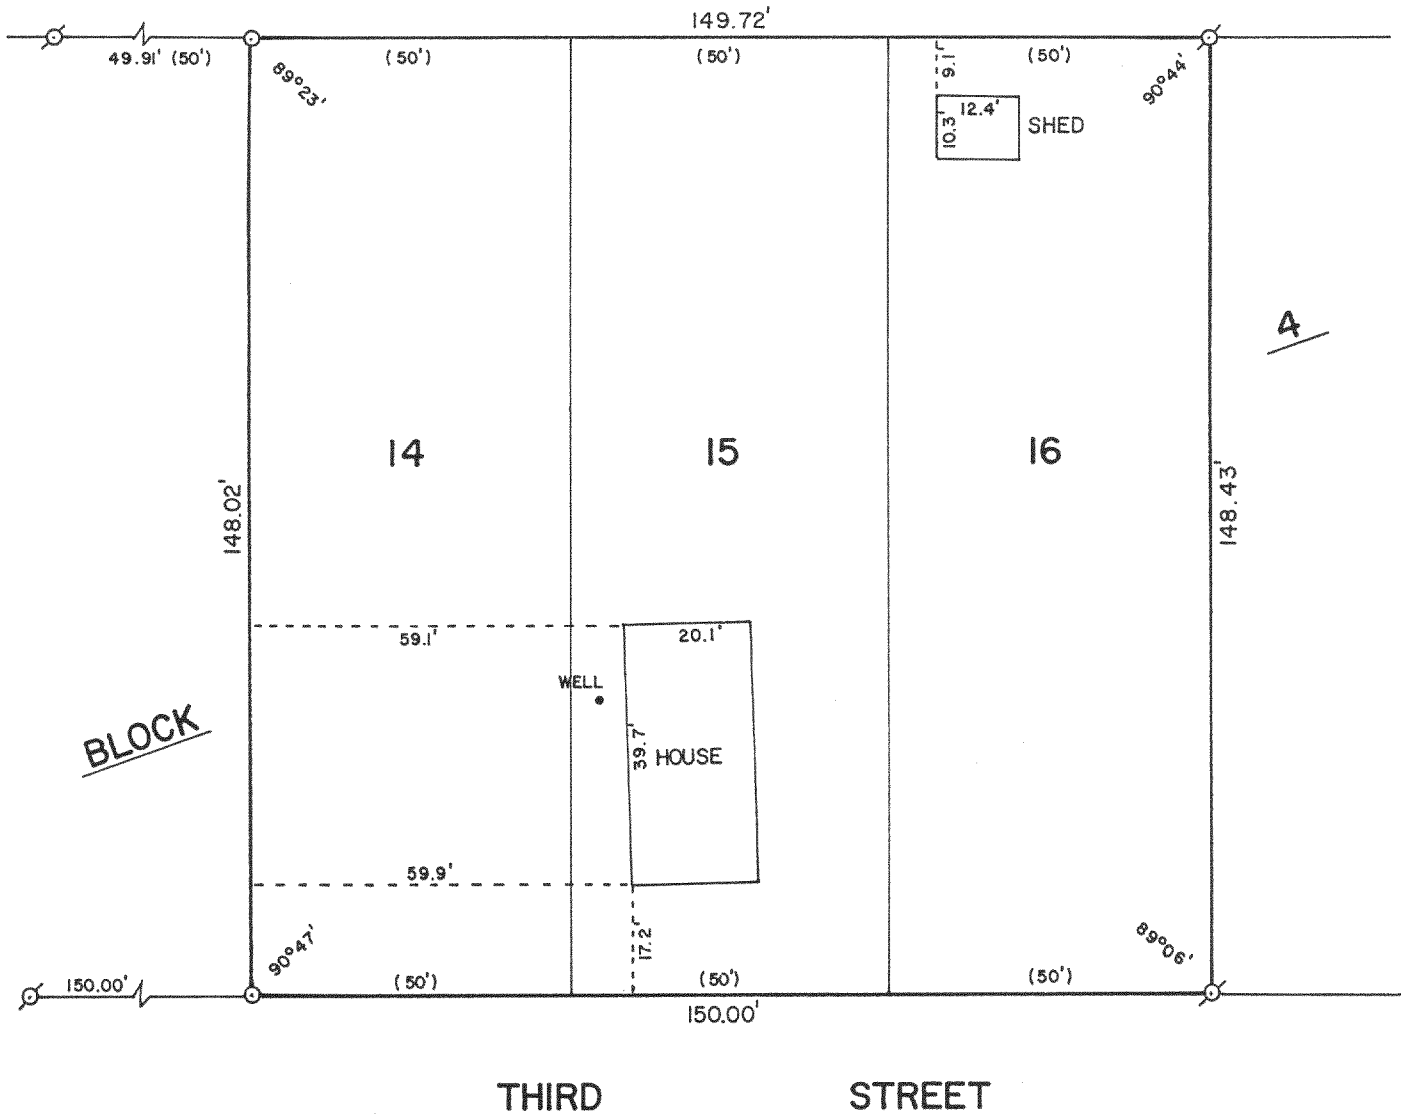


PLAT OF SURVEY OF

LOTS 14-16, BLOCK 4, INLET OAKS SUBDIVISION NO. 3, T2N, R16E,
WALWORTH COUNTY, WISCONSIN.

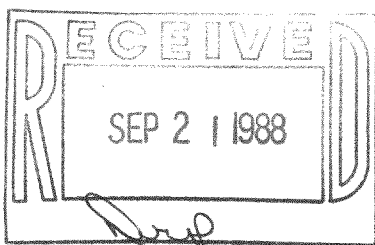

ORDERED BY: CENTURY 21 - SKANDIA REALTY
312 S. 7th STREET
DELAVER, WISCONSIN 53115

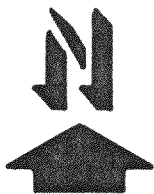

SCALE - 1"=30'

LEGEND

- Ø - IRON PIPE FOUND
- - IRON ROD SET
- () - RECORDED AS

I, DAVID F. ABELL, DO HEREBY CERTIFY
THAT I HAVE SURVEYED THE PROPERTY
HEREON DESCRIBED ACCORDING TO THE
OFFICIAL RECORDS AND THAT THE PLAT
HEREON IS A CORRECT REPRESENTATION
OF THE PROPERTY LINES TO THE BEST OF
MY KNOWLEDGE AND BELIEF.

David F. Abell

DAVID F. ABELL
WISCONSIN REGISTERED LAND SURVEYOR, S-1596

June 29, 1988

JUNE 29, 1988 JOB NUMBER - 88128

NOTE: THIS IS NOT A CERTIFIED COPY UNLESS SEALED.