




ABELL
SURVEYING & MAPPING
 DELAVAN, WISCONSIN 53115
 414-728-6737

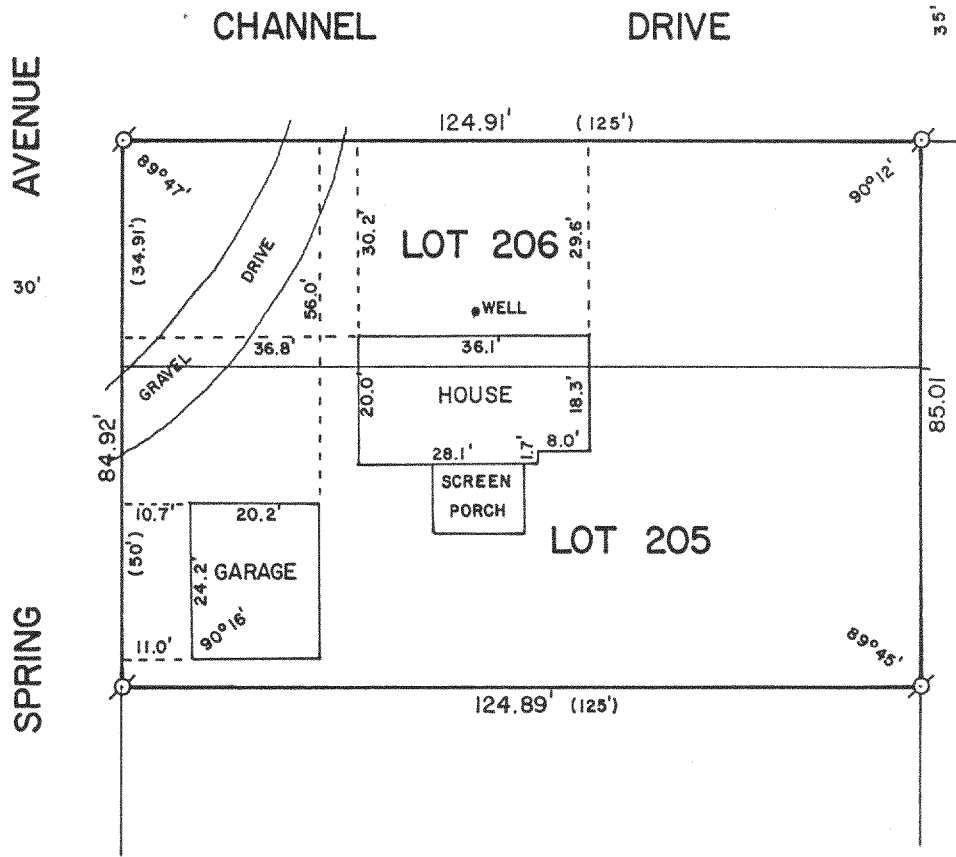

PLAT OF SURVEY OF

LOTS 205 AND 206, LAKE DELAVAN HIGHLANDS, LOCATED
 IN THE SOUTHEAST 1/4 OF SECTION 31, T2N, R16E,
 WALWORTH COUNTY, WISCONSIN.

ORDERED BY: CENTURY 21 - SKANDIA REALTY
 312 S. 7th STREET
 DELAVAN, WI. 53115

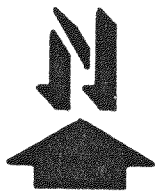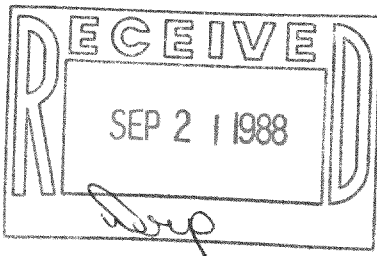

SCALE - 1"=30'

LEGEND

- ⊗ - IRON PIPE FOUND
- () - RECORDED AS

I, DAVID F. ABELL, DO HEREBY CERTIFY
 THAT I HAVE SURVEYED THE PROPERTY
 HEREON DESCRIBED ACCORDING TO THE
 OFFICIAL RECORDS AND THAT THE PLAT
 HEREON IS A CORRECT REPRESENTATION
 OF THE PROPERTY LINES TO THE BEST OF
 MY KNOWLEDGE AND BELIEF.

David F. Abell

 DAVID F. ABELL
 WISCONSIN REGISTERED LAND SURVEYOR, S-1596

July 16, 1988

 DATE: JOB NUMBER - 88150

NOTE: THIS IS NOT A CERTIFIED COPY UNLESS SEALED.