


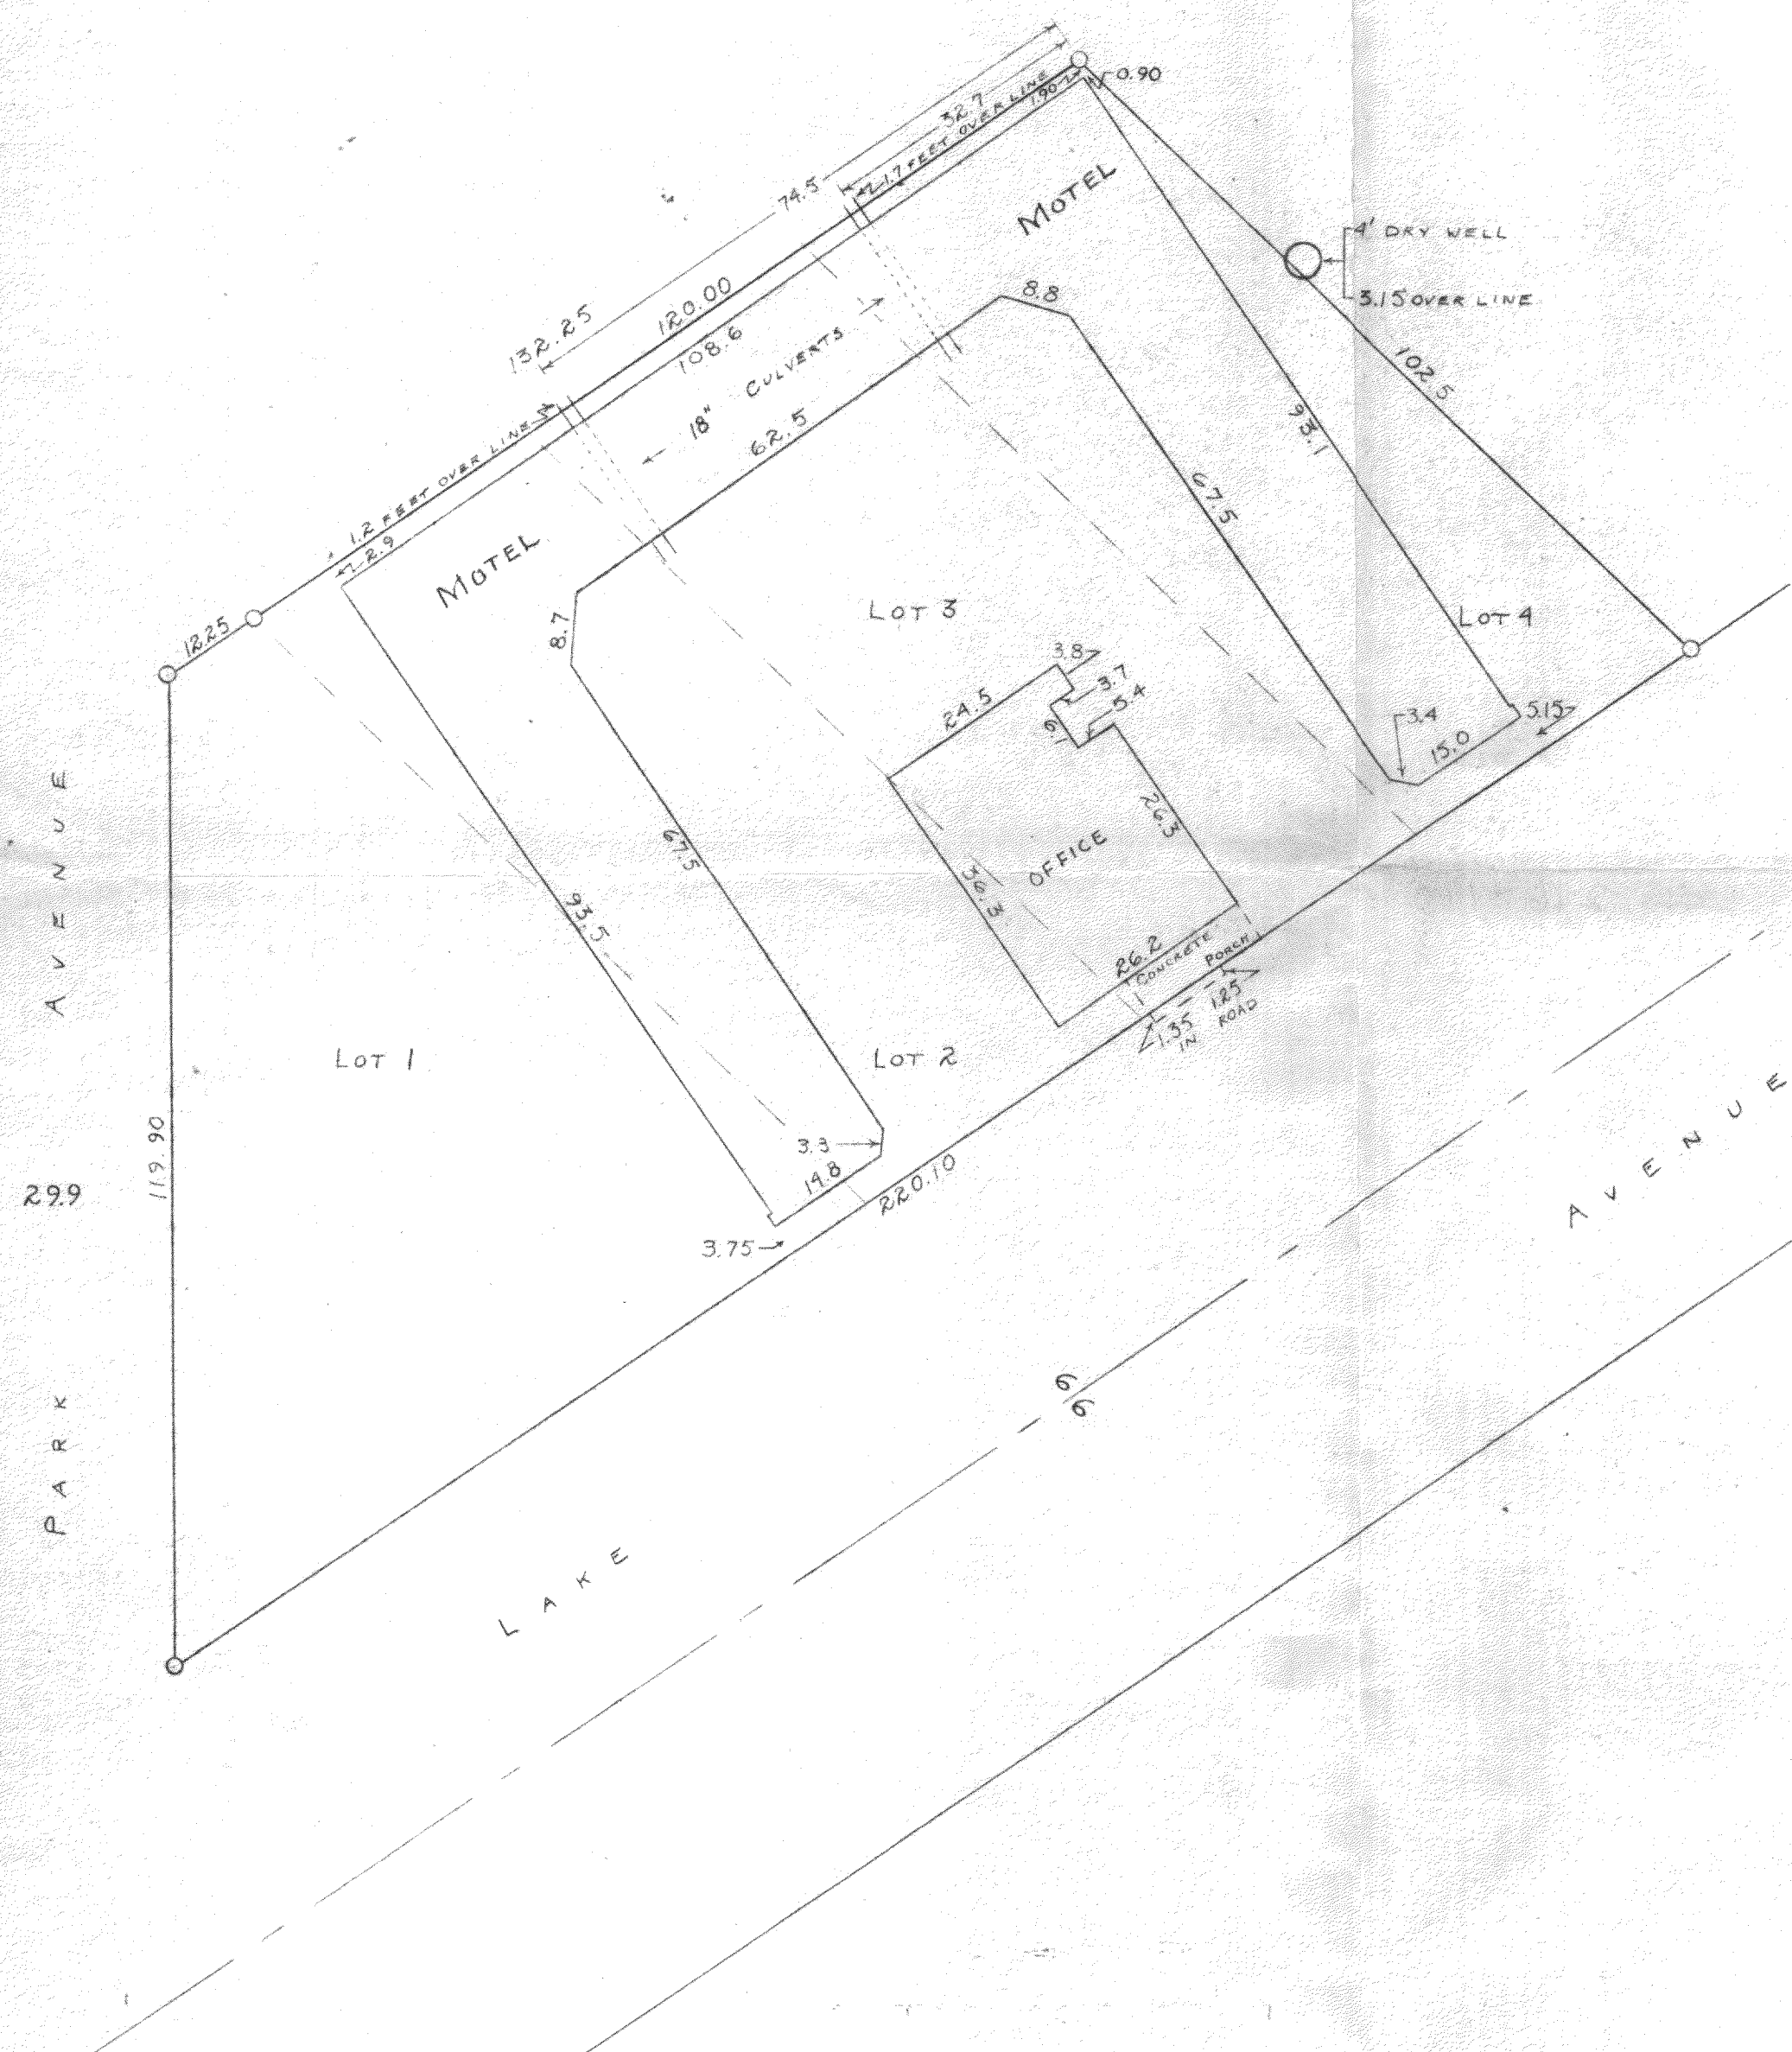

SCALE 1"=20'
O=IRON PIPE

PLAT OF SURVEY OF LOTS 1, 2, 3, AND 4 BLK 4
OF SOUTH SHORE MANOR LOCATED IN SECTION
32, T2N R1E, WALWORTH COUNTY, WISCONSIN
SEPTEMBER 2, 1959

George J. Dunham
GEORGE J. DUNHAM, SURVEYOR
DELAVER, WISCONSIN