
ABELL

SURVEYING & **MAPPING** DELAVAN, WISCONSIN 53115

414-728-6737



LANE

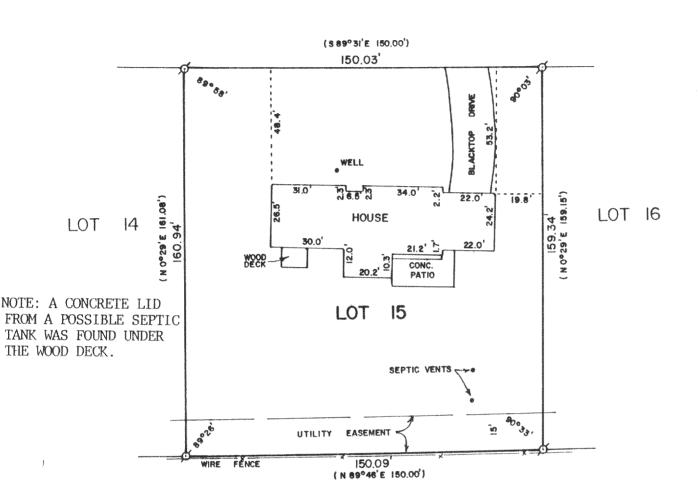


PLAT OF SURVEY OF

LOT 15 OF OAK MEADOW SUBDIVISION, LOCATED IN THE NORTH-EAST 1/4 OF SECTION 29, T2N, R16E, WALWORTH COUNTY, WISCONSIN.

ORDERED BY:

CENTURY 21 - SKANDIA REALTY

312 S. 7th STREET DELAVAN, WI. 53115

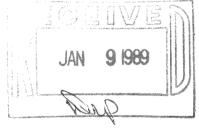



1"=40' SCALE

LEGEND Ø - IRON ROD FOUND)- RECORDED AS

I HEREBY CERTIFY THAT I HAVE SURVEYED THE ABOVE DESCRIBED PROPERTY AND THAT THE ABOVE MAP IS A TRUE REPRESENTATION THEREOF AND SHOWS THE SIZE AND LOCATION OF THE PROPERTY, ITS EXTERIOR BOUNDARIES, THE LOCATION OF ALL VISIBLE STRUCTURES AND DIMENSIONS OF ALL PRINCIPAL BUILDINGS THEREON, BOUNDARIES FENCES, APPARENT EASEMENTS, ROADWAYS AND VISIBLE ENCROACHMENTS, IF ANY, TO THE BEST OF MY KNOWLEDGE AND BELIEF.

THIS SURVEY IS MADE FOR THE USE OF THE PRESENT OWNERS OF THE PROPERTY, AND ALSO THOSE WHO PURCHASE, MORTGAGE, OR GUARANTEE THE TITLE THERETO WITHIN ONE (1) YEAR FROM DATE HEREOF.

WISCONSIN REGISTERED LAND SURVEYOR, S-1596

August 25, 1988

JOB NUMBER - 88197

THIS IS NOT A CERTIFIED COPY UNLESS SEALED. NOTE: