


ABELL  
SURVEYING & MAPPING  
DELAVAN, WISCONSIN 53115  
414-728-6737

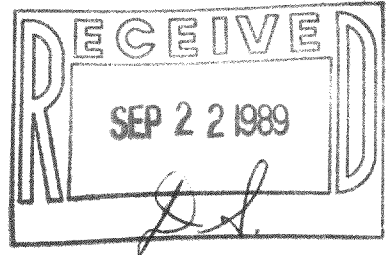

PLAT OF SURVEY OF

THE SOUTH 83 FEET 4 INCHES OF LOTS 13-25,  
BLOCK 3, DELAVAN LAKE VIEW CREST, LOCATED  
IN SECTION 31, T2N, R16E, WALWORTH COUNTY,  
WISCONSIN.

ORDERED BY: CENTURY 21 - SKANDIA REALTY  
312 S. 7th STREET  
DELAVAN, WI 53115


RESURVEYED MAY 4, 1989,  
ORDERED BY: BRAIN THALDORF  
RT. 4, BOX 71A  
DELAVAN, WI. 53115



SCALE - 1"=50'

LEGEND

- ⊘ - IRON PIPE FOUND
- ( ) - RECORDED AS
- - IRON PIPE SET 5/4/89
- IRON PIPE 0.95' NORTH OF LINE

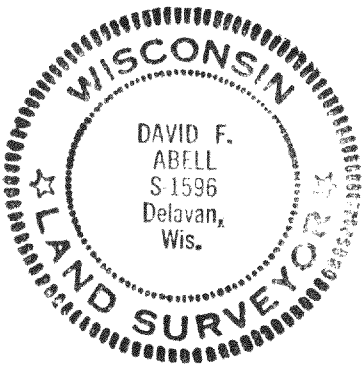

I, DAVID F. ABELL, DO HEREBY  
CERTIFY THAT I HAVE SURVEYED  
THE PROPERTY HEREON DESCRIBED  
ACCORDING TO THE OFFICIAL  
RECORDS, AND THAT THE PLAT  
HEREON IS A CORRECT REPRESENTA-  
TION OF THE PROPERTY LINES TO THE  
BEST OF MY KNOWLEDGE AND BELIEF.

*David F. Abell*

DAVID F. ABELL  
WIS. REGISTERED LAND SURVEYOR, S-1596

DATE June 19, 1986 JOB NUMBER - 86013

REVISED: MAY 4, 1989

